

REV. NO.	DESCRIPTION	DATE	DRN	CHK
0	AS BUILT	05/01/01	GU	


<b>G-H Systems</b> SYSTEMS FOR WATER AND WASTEWATER TREATMENT	
10805 METRIC BLVD. TELEPHONE: (512) 636-3983	AUSTIN, TEXAS 78758 FAX: (512) 636-4441


  

THIS DRAWING IS THE PROPERTY OF G-H SYSTEMS, INC. AND IS NOT TO BE REPRODUCED OR TRANSMITTED IN ANY FORM OR BY ANY MEANS, ELECTRONIC OR MECHANICAL, INCLUDING PHOTOCOPYING, RECORDING, OR BY ANY INFORMATION STORAGE AND RETRIEVAL SYSTEM, WITHOUT THE EXPRESS WRITTEN PERMISSION OF G-H SYSTEMS, INC.	
WASTEWATER TREATMENT PLANT GRIT & GREASE COLLECTOR CONTROL PANEL ELECTRICAL WIRING DIAGRAM	
DRAWN BY: RM	DATE: 06/20/00
APPROV. BY: GU	DATE: 09/15/00
SCALE: NTS	JOB NO.: 00-665
FILE: 00665-07	DWG. NO.: 07-01-1


  

B	REV.
	0

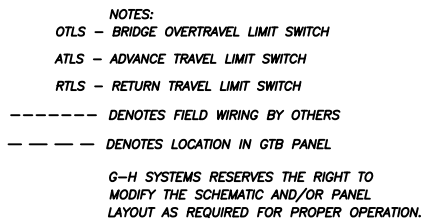
CP-1768

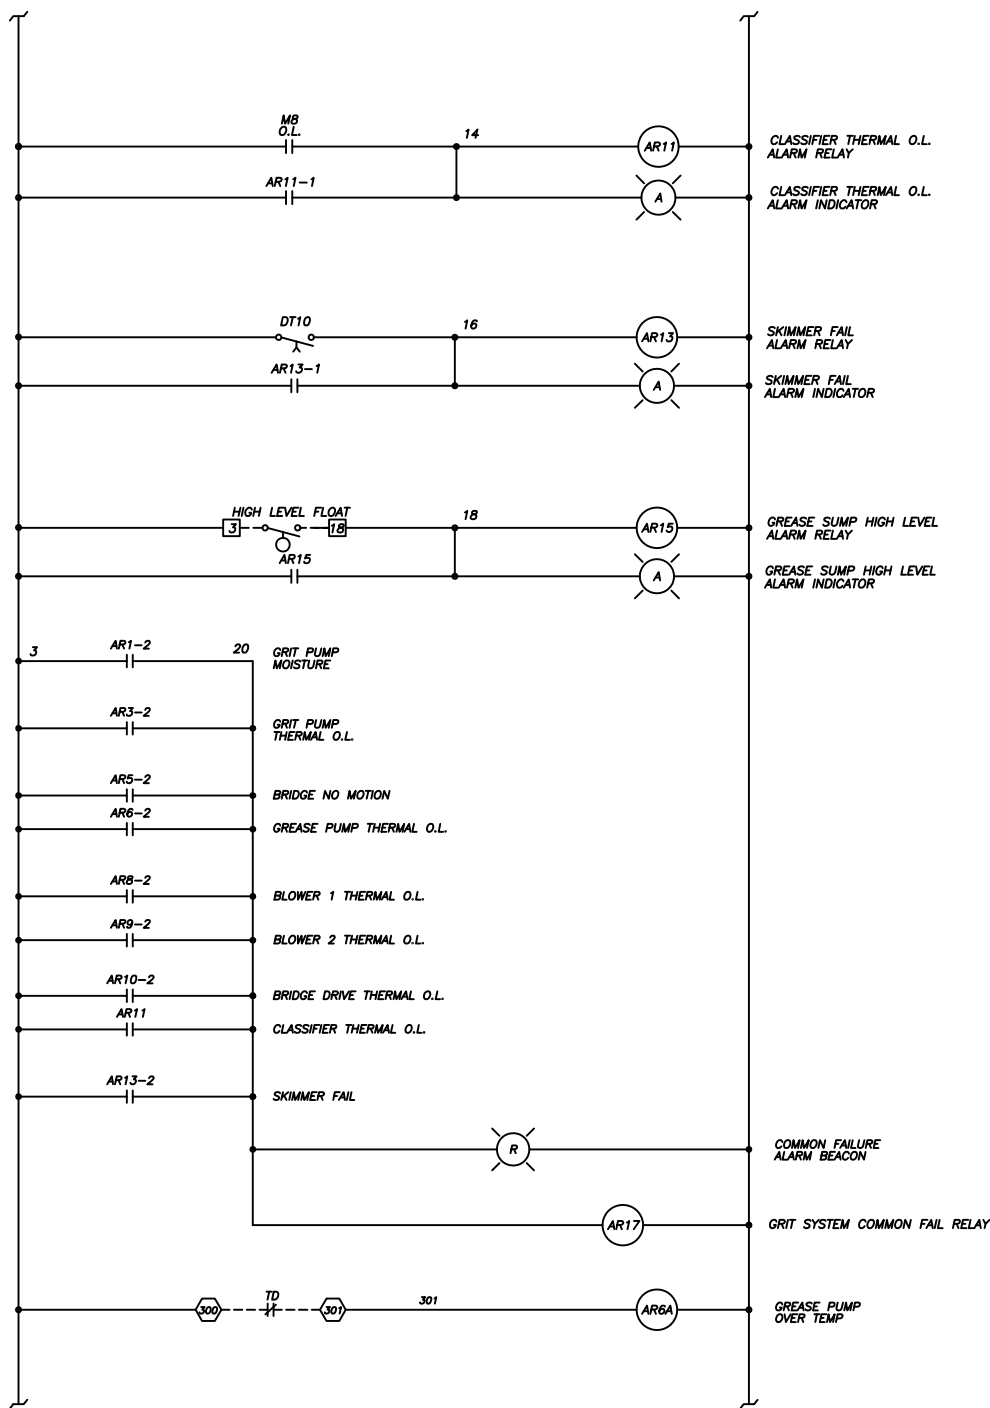

REV. NO.	DESCRIPTION	DATE	DRN	CHK
0	AS BUILT	05/01/01	GU	
<b>G-H Systems</b> SYSTEMS FOR WATER AND WASTEWATER TREATMENT 10805 METRIC BLVD. - AUSTIN, TEXAS 78758 TELEPHONE: (512) 836-3983 - FAX: (512) 836-4441 INFORMATION IS CONTAINED HEREIN IS THE PROPERTY OF G-H SYSTEMS, INC. REPRODUCTION OR TRANSMISSION IN ANY FORM OR BY ANY MEANS, WITHOUT THE EXPRESS WRITTEN PERMISSION OF G-H SYSTEMS, INC. IS PROHIBITED.				
WASTEWATER TREATMENT PLANT GRIT & GREASE COLLECTOR CONTROL PANEL ELECTRICAL WIRING DIAGRAM				
DRAWN BY: RM DATE: 06/20/00 SHT 3 OF 9 APP'D. BY: GU DATE: 09/15/00 SCALE: NTS JOB NO. 00-665 FILE: 00665-07 DWS. NO. 07-01-1				
B				REV. 0

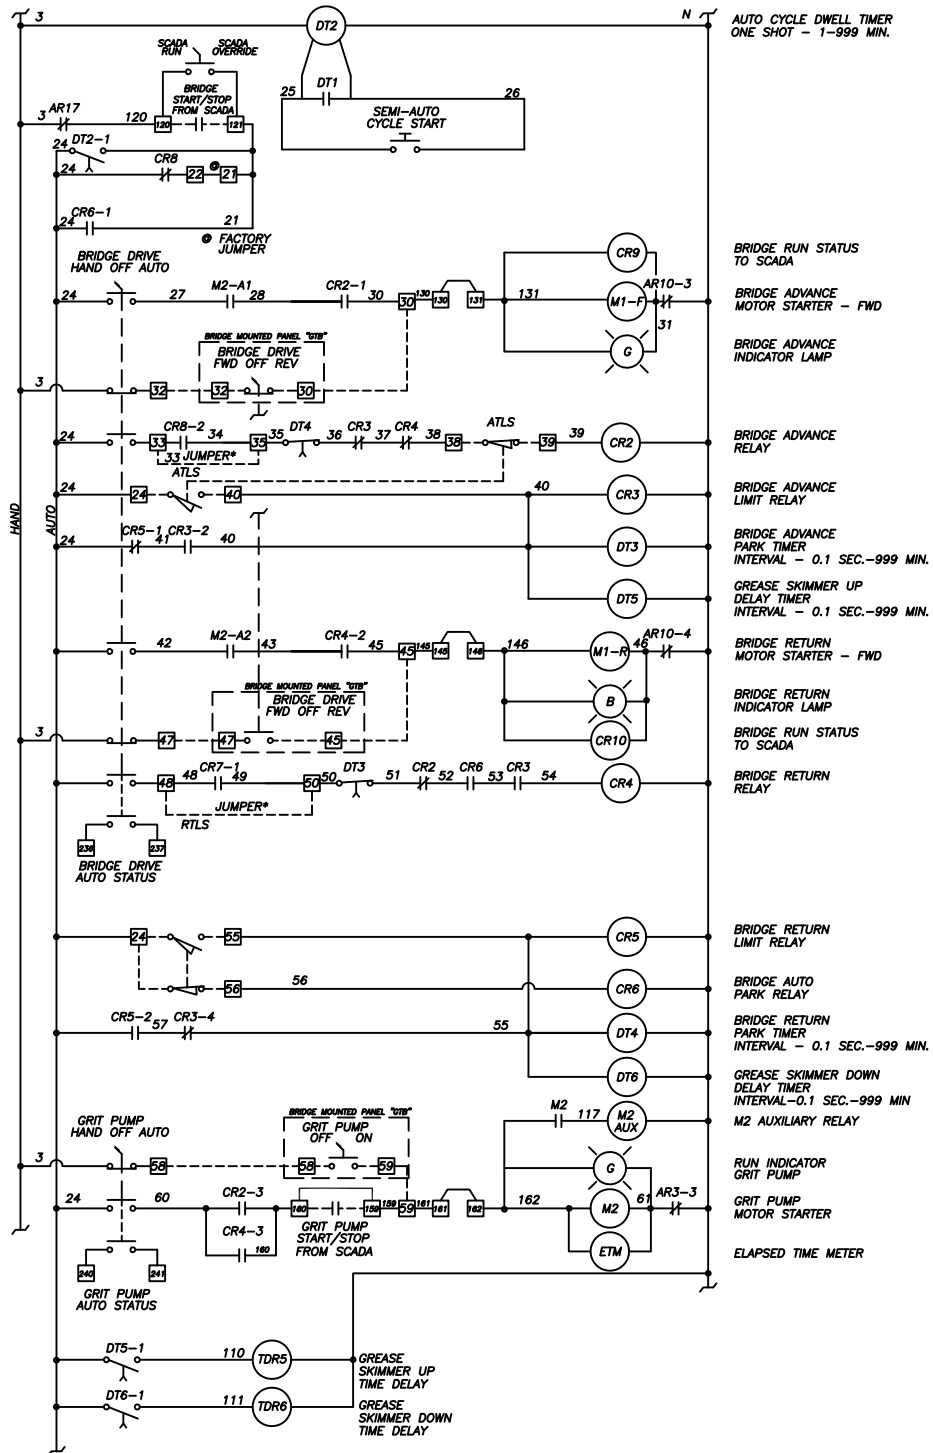


0		AS BUILT		05/01/01		GU		DATE		DRN		CHK	
REV. NO.		DESCRIPTION		DATE		BY		CHK		DATE		CHK	
<div><div>G-H Systems</div><div>FOR WATER AND WASTEWATER TREATMENT</div></div>													
10805 METRIC BLVD. — AUSTIN, TEXAS — 78758 TELEPHONE: (512) 636-3983 — FAX: (512) 636-4441													
INFORMATION CONTAINED HEREIN IS THE PROPERTY OF G-H SYSTEMS, INC. AND IS LOANED TO YOUR COMPANY. IT IS NOT TO BE REPRODUCED OR TRANSMITTED IN ANY FORM OR BY ANY MEANS, ELECTRONIC OR MECHANICAL, INCLUDING PHOTOCOPYING, RECORDING, OR BY ANY INFORMATION STORAGE AND RETRIEVAL SYSTEM, WITHOUT THE EXPRESS WRITTEN PERMISSION OF G-H SYSTEMS, INC.													
WASTEWATER TREATMENT PLANT GRIT & GREASE COLLECTOR CONTROL PANEL ELECTRICAL WIRING DIAGRAM REPUBLIC, MO													
B		DRAWN BY: RM		DATE: 06/20/00		SHEET 4 OF 9		REV.		0		0	
		APPROVED BY: RM		DATE: 09/15/00		JOB NO. 00-665							
		SCALE: NTS											
		FILE: 00665-07											
		DWG. NO. 07-01-1											

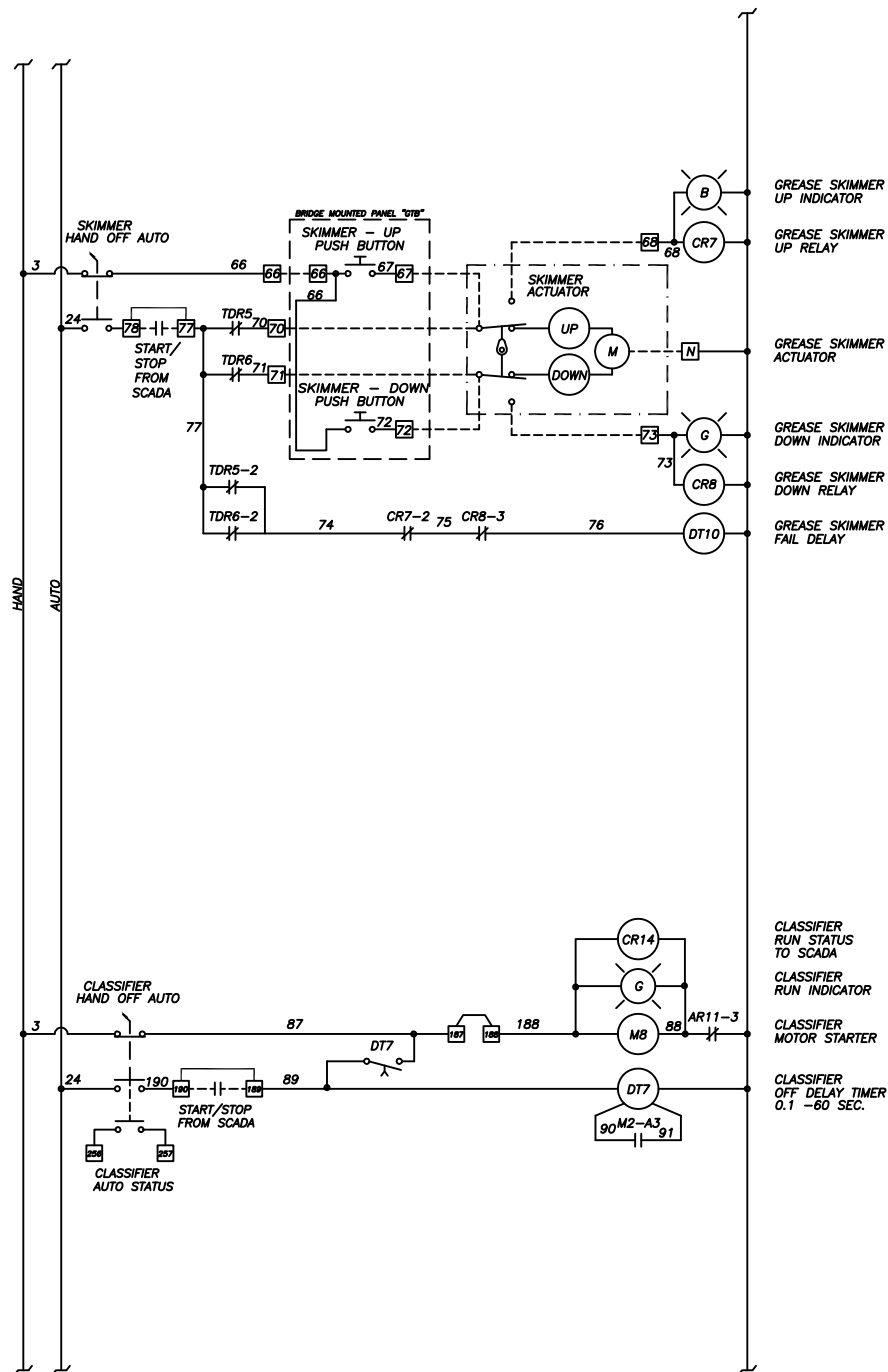


REV. NO.	AS BUILT	DESCRIPTION	DATE	DRN	CHK
0			05/01/01	00	
<b>G-H Systems</b> SYSTEMS FOR WATER AND WASTEWATER TREATMENT 10805 METRIC BLVD. - AUSTIN, TEXAS - 78758 TELEPHONE: (512) 836-3983 - FAX: (512) 836-4441					
THIS DRAWING AND ALL INFORMATION IT CONTAINS ARE THE PROPERTY OF G-H SYSTEMS, INC. AND ARE NOT TO BE REPRODUCED OR TRANSMITTED IN ANY FORM OR BY ANY MEANS, ELECTRONIC OR MECHANICAL, INCLUDING PHOTOCOPYING, RECORDING, OR BY ANY INFORMATION STORAGE AND RETRIEVAL SYSTEM, WITHOUT THE EXPRESS WRITTEN PERMISSION OF THE EQUIPMENT MANUFACTURER.					
WASTEWATER TREATMENT PLANT GRIT & GREASE COLLECTOR CONTROL PANEL ELECTRICAL WIRING DIAGRAM					
DRAWN BY: RM	DATE: 06/20/00	SHT 5 OF 9	REV.		
APPR'D. BY: GU	DATE: 09/15/00	JOB NO. 00-665	REV.		
SCALE: NTS			REV.		
FILE: 00665-07	DNF. NO. 07-01-1		REV.		



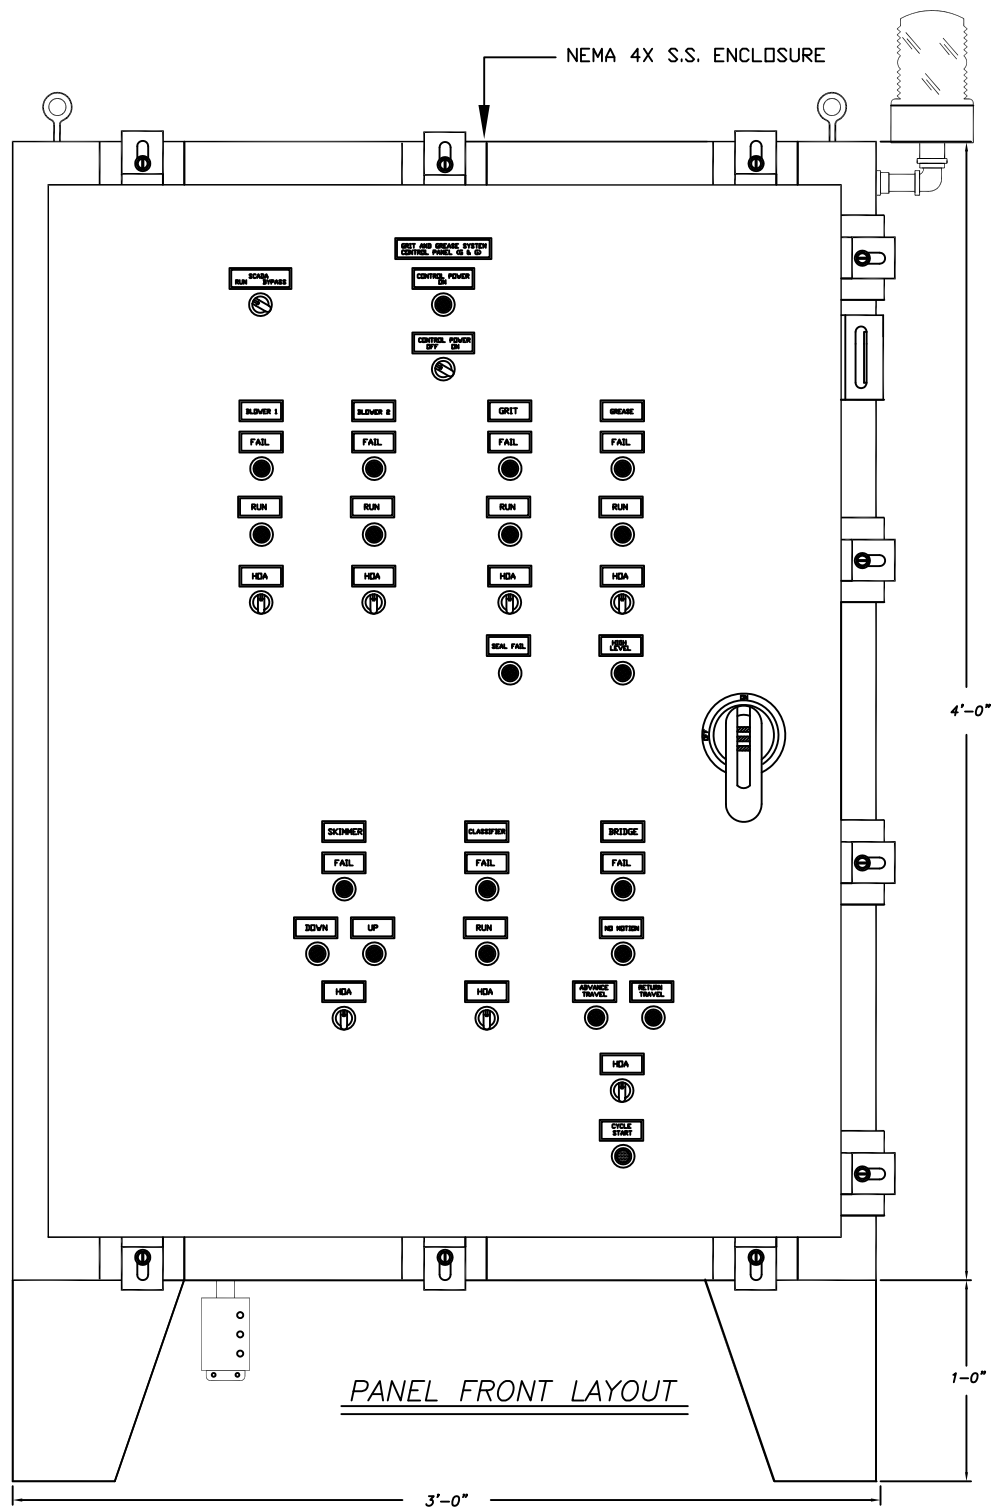

0	AS BUILT	05/01/01	00
REV. NO.	DESCRIPTION	DATE	DRN CHK
<b>G-H Systems</b> SYSTEMS FOR WATER AND WASTEWATER TREATMENT 10805 METRIC BLVD. - AUSTIN, TEXAS - 78758 TELEPHONE: (512) 836-3883 - FAX: (512) 836-4441 THIS DRAWING AND ALL INFORMATION IT CONTAINS ARE THE PROPERTY OF G-H SYSTEMS, INC. AND ARE NOT TO BE REPRODUCED OR TRANSMITTED IN ANY FORM OR BY ANY MEANS, ELECTRONIC OR MECHANICAL, INCLUDING PHOTOCOPYING, RECORDING, OR BY ANY INFORMATION STORAGE AND RETRIEVAL SYSTEM, WITHOUT THE EXPRESS WRITTEN PERMISSION OF G-H SYSTEMS, INC.			
WASTEWATER TREATMENT PLANT GRIT & GREASE COLLECTOR CONTROL PANEL ELECTRICAL WIRING DIAGRAM			
DRAWN BY: RM	DATE: 06/20/00	SHT 7 OF 9	REV.
APPR'D. BY: GU	DATE: 09/15/00	JOB NO. 00-665	
SCALE: NTS		DRG. NO. 07-01-1	
FILE: 00065-07			
B			0

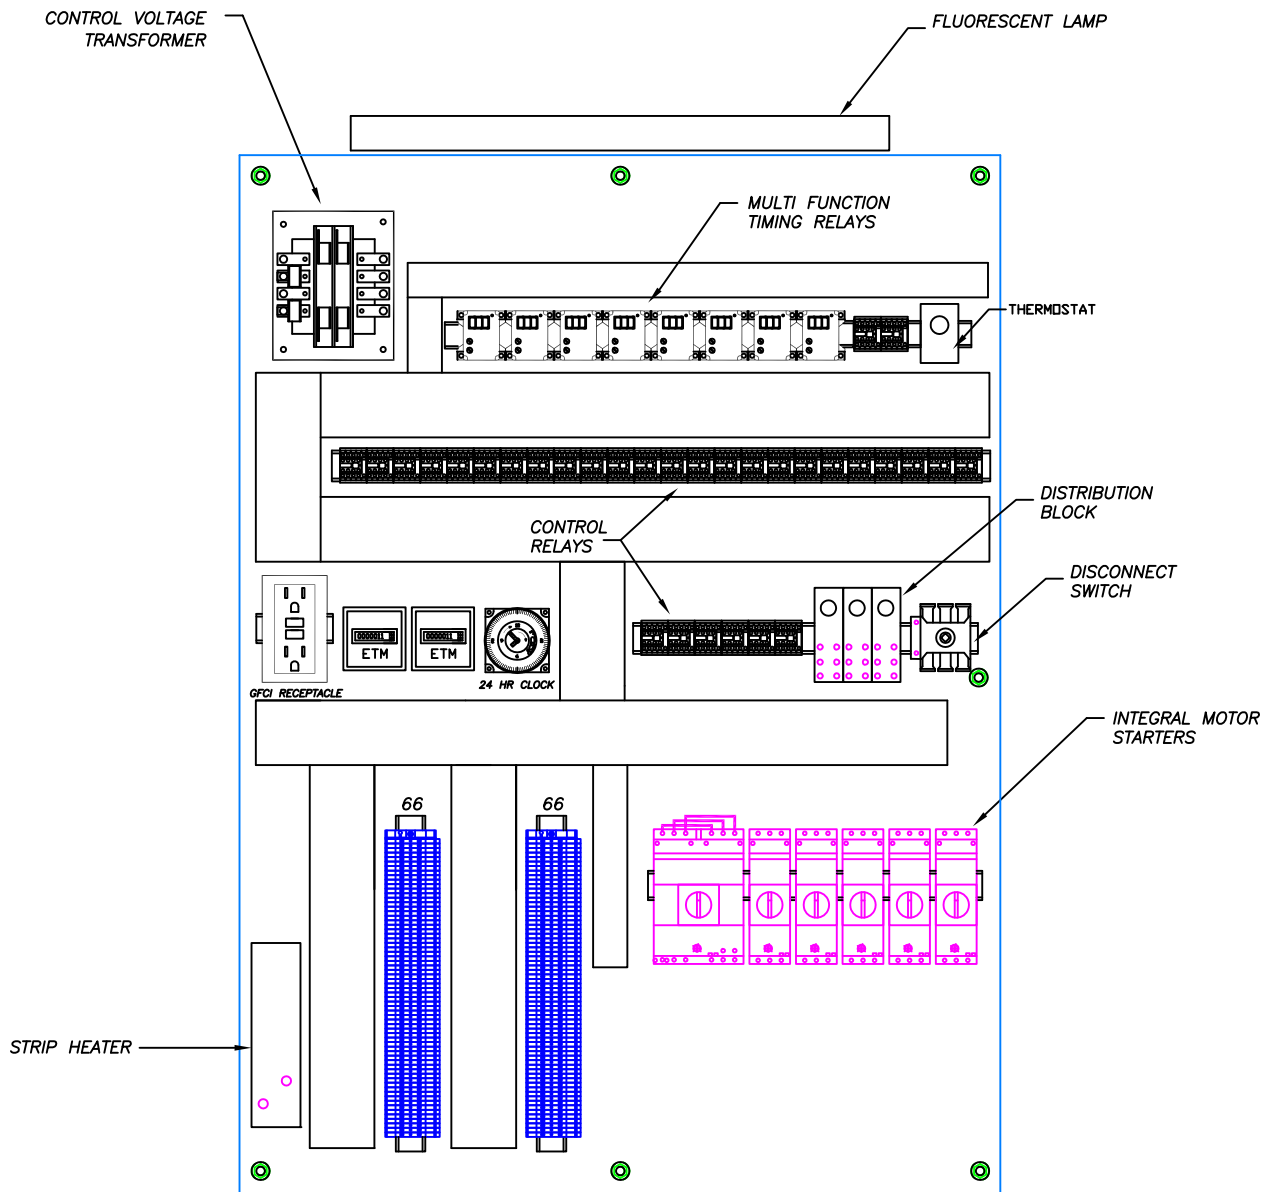

BACK PANEL LAYOUT

0	AS BUILT	05/01/01	01	REV.
1	DESCRIPTION	DATE	DRN	CHK
<b>G-H Systems</b> SYSTEMS FOR WATER AND WASTEWATER TREATMENT 10805 METRIC BLVD. - AUSTIN, TEXAS 78758 TELEPHONE: (512) 836-3883 - FAX: (512) 836-4441				
THIS DRAWING AND ALL INFORMATION IT CONTAINS ARE THE PROPERTY OF G-H SYSTEMS, INC. REPRODUCTION OR TRANSMISSION OF THIS DRAWING OR ANY PART THEREOF WITHOUT THE EXPRESS WRITTEN PERMISSION OF G-H SYSTEMS, INC. IS PROHIBITED.				
WASTEWATER TREATMENT PLANT GRIT & GREASE COLLECTOR CONTROL PANEL ELECTRICAL WIRING DIAGRAM				
DRAWN BY: RM	DATE: 06/20/00	SHT 8	OF 9	REV.
APPR'D. BY: GU	DATE: 09/15/00	JOB NO.: 00-665	SCALE: NTS	0
FILE: 00665-07	DNF. NO: 07-01-1			

FINAL PANEL LAYOUT MAY DIFFER FROM SUBMITTAL DRAWINGS



## BILL OF MATERIALS

ITEM	QTY	MANUFACTURER	PART NO.	DESCRIPTION
1	1	EBE	S48368N4X/W12"LEGS & LUGS	ENCLOSURE NEMA 4X SS
1a	1	EBE	A4836P	BACKPLATE
2	1	ABB	OT63E3	DISCONNECT SWITCH
3	1	ABB	OH65L5	HANDLE
4	1	ABB	OX5X265	SHAFT
5	5	TELEMECHANIQUE	LD1LB030FC	INTEGRAL MOTOR STARTER 2,4,6-8
6	1	TELEMECHANIQUE	LD5LB130PFC	INTEGRAL MOTOR STARTER 1
7	1	TELEMECHANIQUE	LB1LB03P06	O.L. 1 (1-1.6A)
8	2	TELEMECHANIQUE	LB1LB03P07	O.L. 4,8 (1.6A-2.5A)
9	1	TELEMECHANIQUE	LB1LB03P08	O.L. 2 (2.5-4A)
10	2	TELEMECHANIQUE	LB1LB03P13	O.L. 6,7 (6-10A)
11	1	SQUARE D	9070TF1000D1	TRANSFORMER 1KVA
12	3	AB	800H-HR2A	2 POSITION SWITCH
13	11	AB	800H-QR10A	AMBER PILOT LIGHT
14	6	AB	800H-QR10G	GREEN PILOT LIGHT
15	2	AB	800H-QR10B	BLUE PILOT LIGHT
16	7	AB	800H-JR2A	3 POSITION SWITCH
17	1	INTERMATIC	IG4803LDH	TVSS SURGE SUPPRESSOR
18	2	HOFFMAN	A-TEMNC	THERMOSTAT
19	2	WATLOW	375	STRIP HEATER
20	23	OMRON	MY41NAC120	CONTROL RELAYS
21	1	GRASSLIN	FM/1 STUZH	24 HR TIMER
22	10	DAYTON	6A855	MULTIFUNCTION TIMER
23	2	REDDINGTON	711-0187	ETM
24	2	REDDINGTON	712-0005	ETM DIN MOUNT
25	2	AB	800H-AR1A	PUSH BUTTON
26	1	TOMAR	495-1280-R	RED STROBE LIGHT
27	1	MARATHON	1323580	DISTRIBUTION BLOCK
28	1	ABB	OA2G11	DISCONNECT AUX. CONTACT
29	1	STOCK		INTERNAL LIGHT
30	1	STOCK		GFI RECEPTACLE
31	1	EBE	S20168N4X	ENCLOSURE NEMA 4X SS
32	1	EBE	A2016P	BACKPLATE
33	6	OMRON	MY2INAC120	CR9-14
34	9	A-B	800T-XA	AUX. CONTACT BLOCKS

<b>0</b>	REV. NO.	DESCRIPTION	DATE	BY	CHK
<b>B</b>		AS BUILT	05/01/01	GU	
10805 METRIC BLVD. - AUSTIN, TEXAS - 78758 TELEPHONE: (512) 836-3883 - FAX: (512) 836-4441					
THIS DRAWING AND ALL INFORMATION IT CONTAINS ARE THE PROPERTY OF G-H SYSTEMS, INC. REPRODUCTION OR TRANSMISSION OF ANY KIND WITHOUT THE EXPRESS WRITTEN PERMISSION OF G-H SYSTEMS, INC. IS PROHIBITED.					
<b>WASTEWATER TREATMENT PLANT</b> <b>REPUBLIC, MO</b> <b>GRIT &amp; GREASE COLLECTOR CONTROL PANEL</b> <b>ELECTRICAL WIRING DIAGRAM</b>					
DRAWN BY: RM		DATE: 06/20/00	SHT 9	OF 9	REV.
APPROVED BY: GU		DATE: 09/15/00			
SCALE: NTS		JOB NO.: 00-665			
FILE: 00665-07		DWG. NO.: 07-01-1			
<b>0</b>					