

---

---

# COX

Research and Technology, Inc.

---

---

DUPLEX PUMP  
CONTROL PANEL  
GONZALES #28

# AS BUILTS

AUGUST 1, 2005

FIELD REVISIONS

DECEMBER 2021

---

Cox Research and Technology, Inc.  
14697 S. Harrells Ferry Road  
Baton Rouge, LA. 70816  
(225) 756-3271 Fax (225) 755-1030

CP-2119R1

SOLD TO:
TAG:
-

SHIP TO:
-
-


SPECIAL NOTES:
----------------

Panel Type	Duplex
Voltage	240
Phase/HZ	3/60
No. Motors	2
HP	7.5
FLA	23.7
Pump Manufacturer	-
Type of Pump	Submersible
Catalog Number	-
Capacitors	No
Control Voltage	120
Control Power Transformer VA=3K	Yes
Enclosure NEMA Rating	4X
Enclosure Material	Fiberglass
Enclosure Size	24x20x10
Inner Swing Panel	Yes
Conrol Sensor	Floats,Opti
UL508A Labeling	No
UL698A Labeling	No


Alarm Light - Panel Door Mount	
Alarm Light - Panel Top Mount	
Alarm Light - Remote	X
Alarm Test Switch	
Alarm Silence Switch	
Alarm Acknowledge Switch	
Alternator with Lead Pump Selector Switch	
Audible Alarm - Bell	
Audible Alarm - Horn	
Audible Alarm - Piezo	
COX™ CAMO™ System	
Cycle Counters	
Economy Version	
Elapsed Time Meter	
Flasher	
Green Run Lights vs. Red	
Ground Fault Receptacle (Existing)	X
High Temp Lights	
High Temp Pump Shutdown - Auto Reset	
High Temp Pump Shutdown - Manual Reset	
Intrinsically Safe Relays Pts.	
Lightning Arrestor	
Main Disconnect with Door Mt. Handle	
Opti-Float® Level Dectector Pts.	X
Panel Heater / Thermostat W=	
Phase Monitor	
Pole, Box, Seal	
Seal Fail Lights	X
Seal Fail Relay - Fixed	
Seal Fail Relay - Adjustable	X
Seal Fail Shutdown	
Starters - IEC	
Starters - NEMA	
Unpowered Alarm Circuits #	

OTHER:
--------


	Drawing Title						
	PANEL DESCRIPTION						
DATE		REFERENCE DRAWING	NO.	REVISION-LOCATION	ECN	DATE	BY
8/01/05		S/N	Sales Engineer C.C.	Application Engineer R.C.	DRAWN BY C. RACHAL	APPROVED BY	DATE
	Project Title	COX Research and Technology, Inc.			P.O. Box 77808 Baton Rouge, LA 70809  Ph. (225)756-3271 Fax (225)755-1030	PURCHASE ORDER NUMBER	
	DUPLEX PUMP CONTROL PANEL					DRAWING NUMBER CP-2119R1	
						SHEET NUMBER 1	

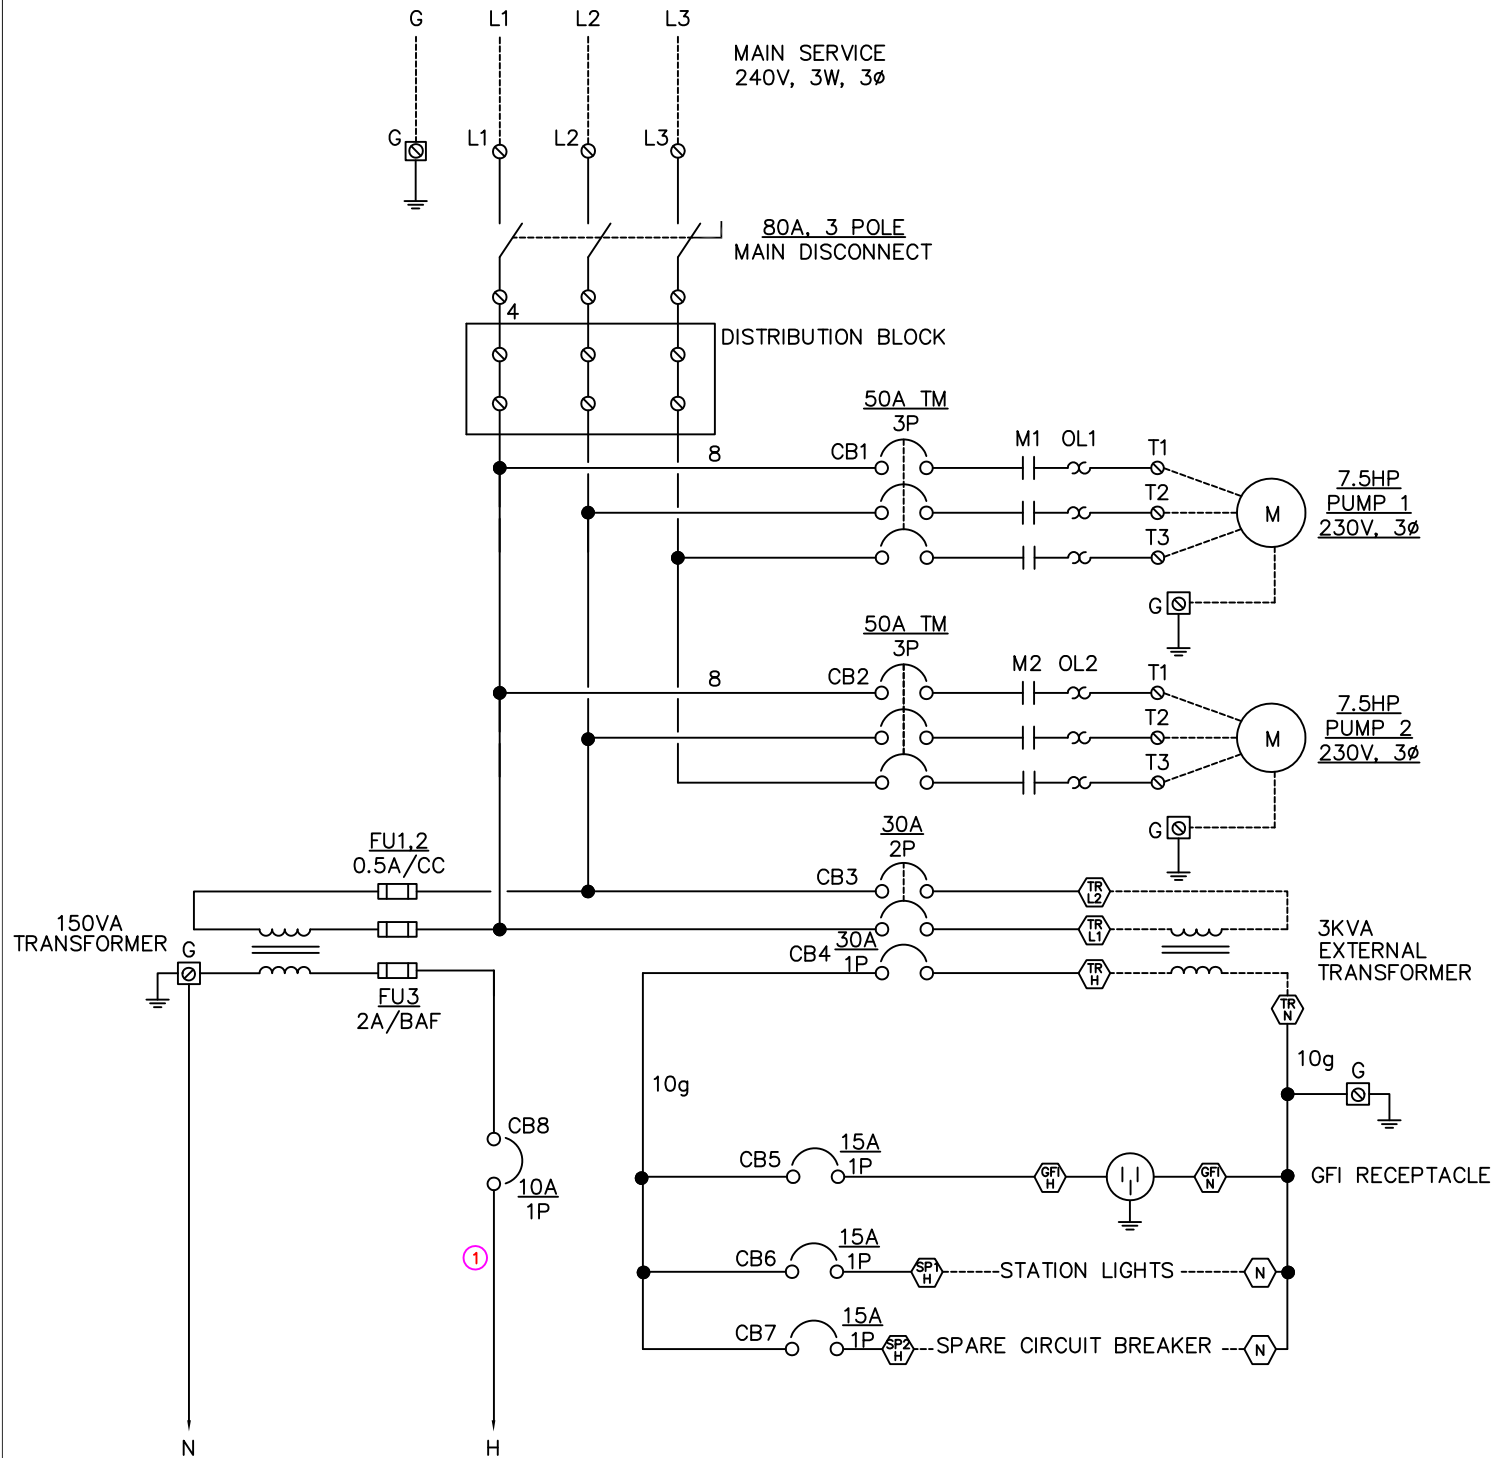

	Drawing Title								
	POWER DIAGRAM								
DATE	8/01/05	REFERENCE DRAWING	NO.	REVISION-LOCATION	ECN	DATE	BY	APPROVED	
		S/N	Sales Engineer C.C.	Application Engineer R.C.	BY C. RACHAL	BY	DATE		
	Project Title	COX			P.O. Box 77808 Baton Rouge, LA 70809	PURCHASE ORDER NUMBER			
	DUPLEX PUMP CONTROL PANEL	Research and Technology, Inc.			Ph. (225)756-3271 Fax (225)755-1030	DRAWING NUMBER CP-2119R1			
						SHEET NUMBER 2			

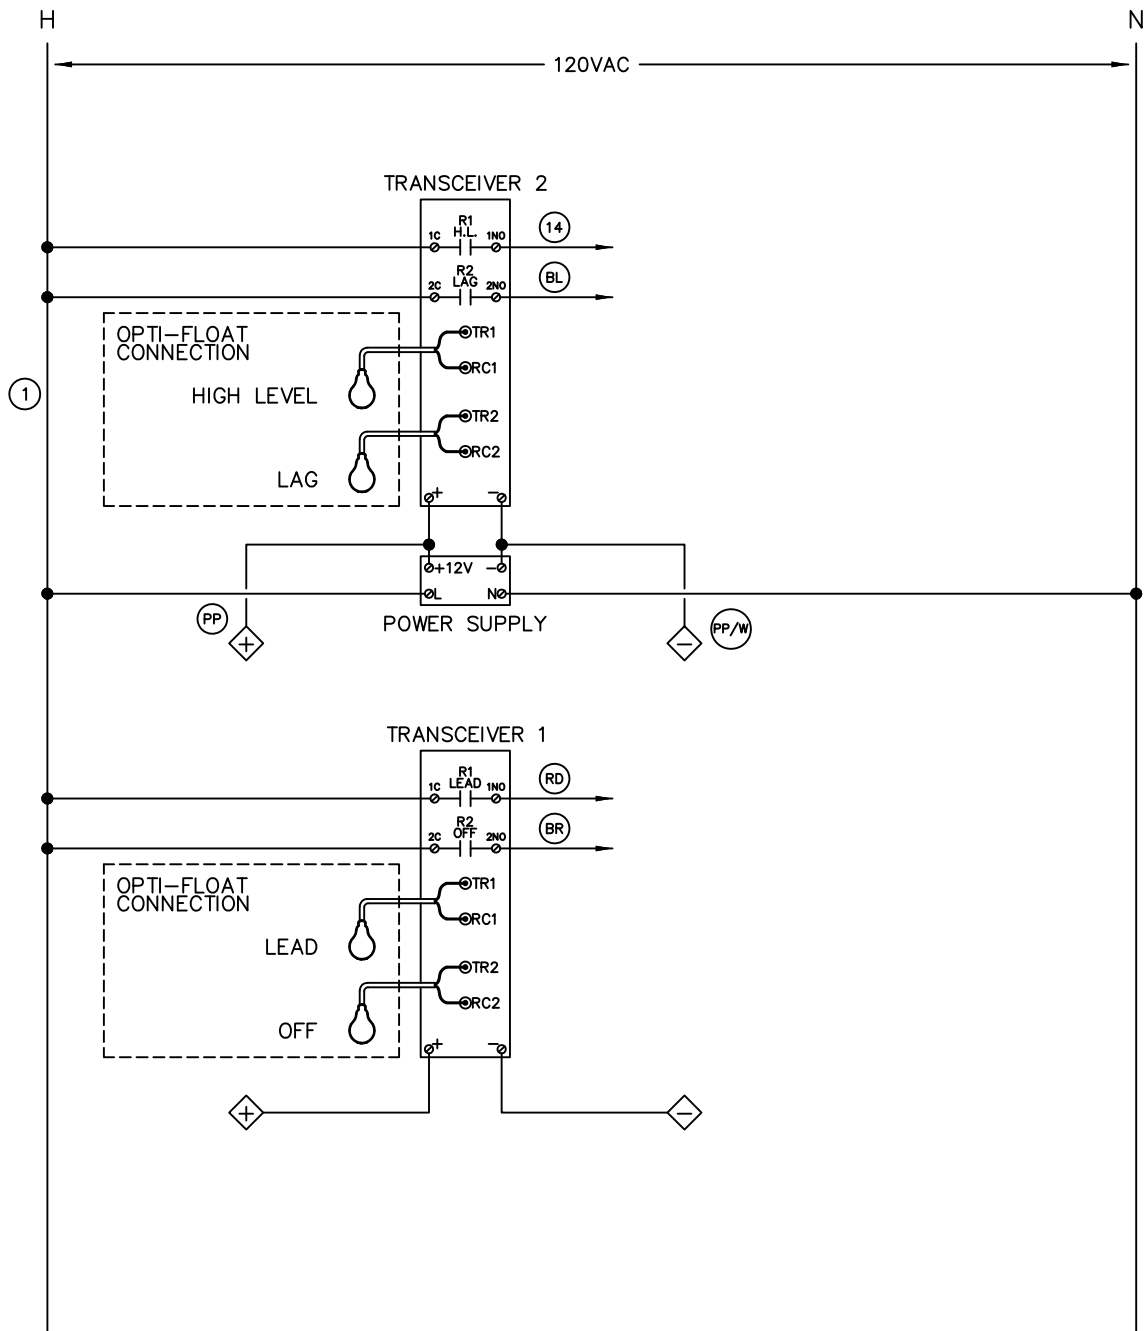


	Drawing Title							
	CONTROL DIAGRAM							
DATE	8/01/05	REFERENCE DRAWING	NO.	REVISION-LOCATION	ECN	DATE	BY	
		S/N	Sales Engineer C.C.	Application Engineer R.C.	BY C. RACHAL	APPROVED	BY	DATE
	Project Title	PURCHASE ORDER NUMBER						
	DUPLEX PUMP CONTROL PANEL	COX Research and Technology, Inc.			DRAWING NUMBER CP-2119R1			
		P.O. Box 77808 Baton Rouge, LA 70809 Ph. (225)756-3271 Fax (225)755-1030			SHEET NUMBER 3			

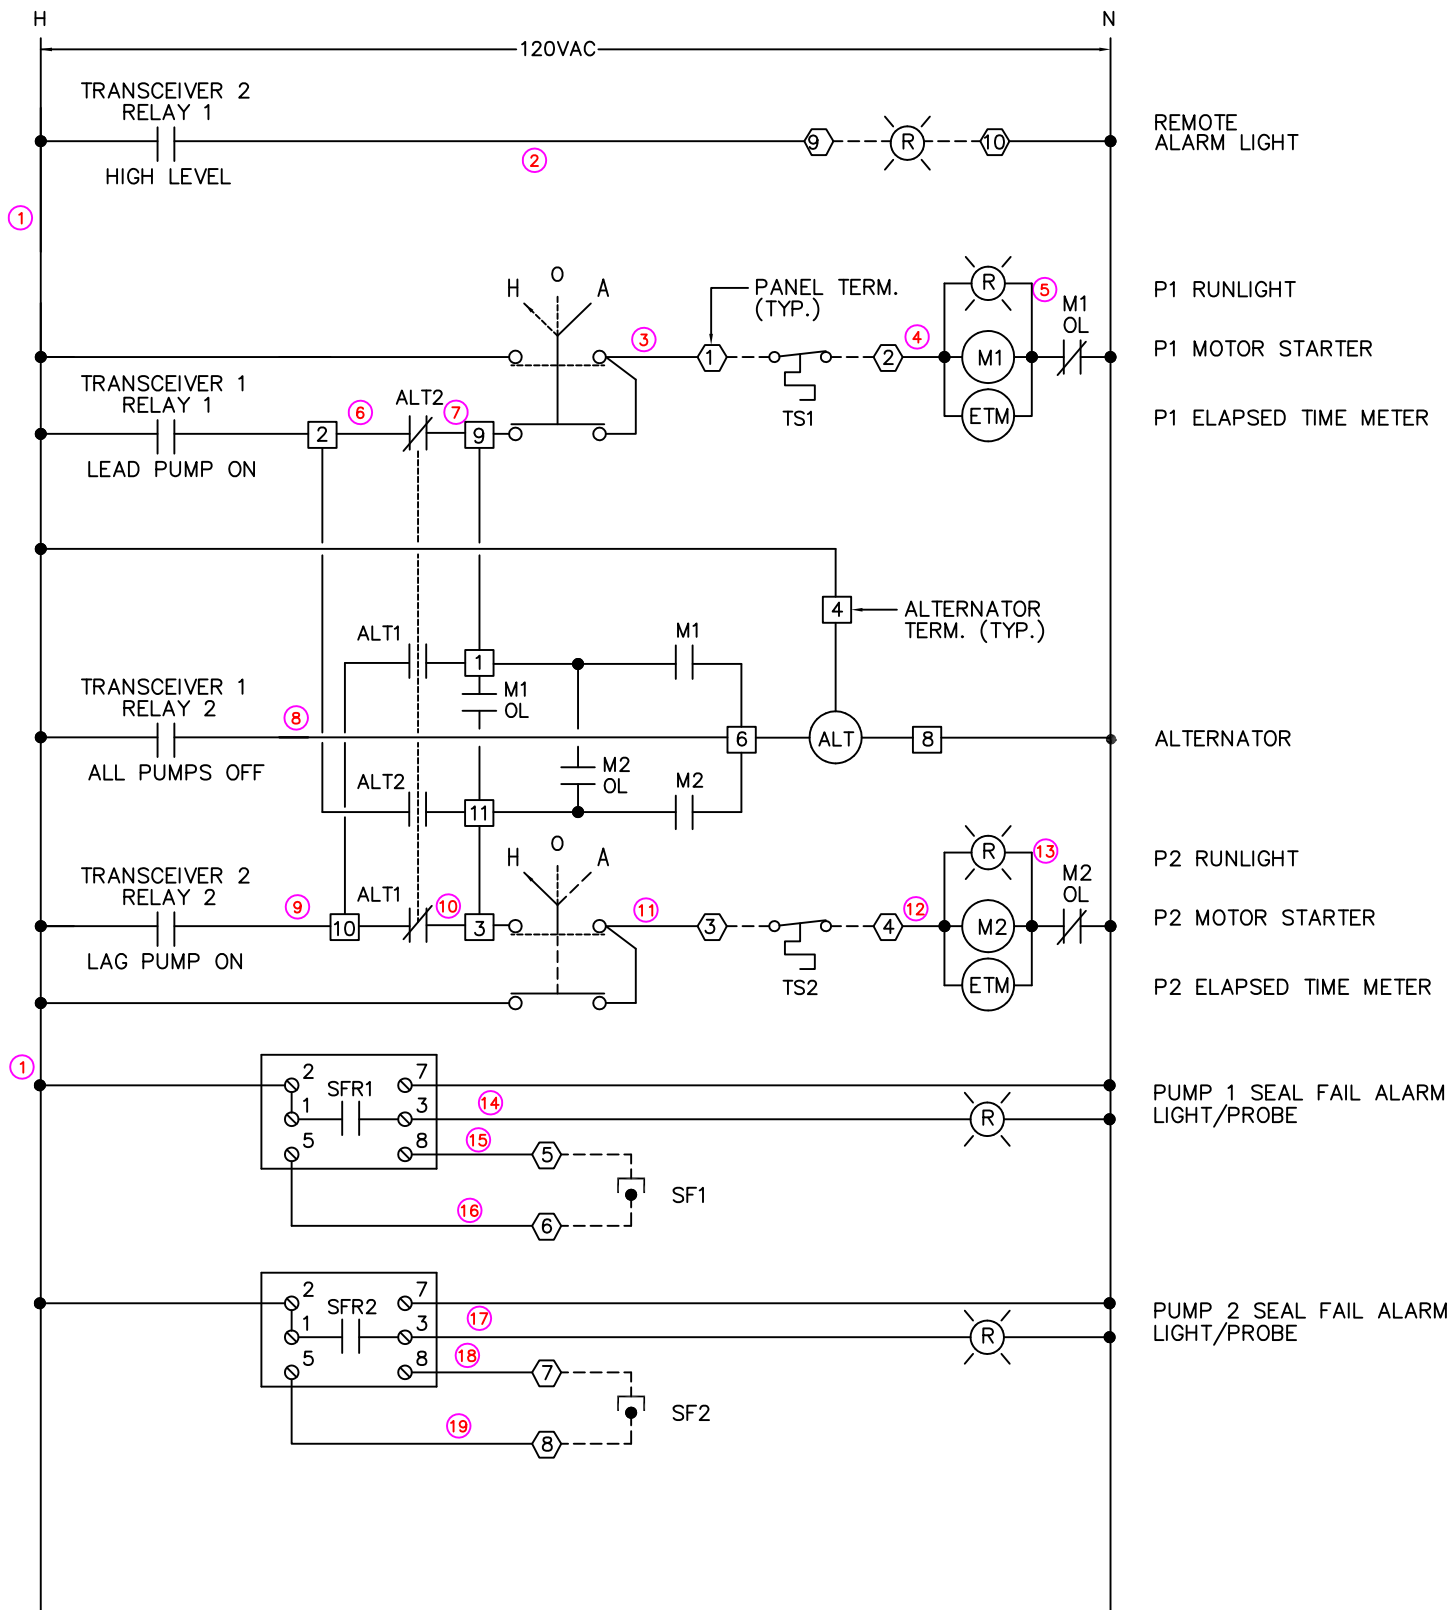

Drawing Title							
CONTROL DIAGRAM							
DATE 8/01/05	REFERENCE DRAWING		NO.	REVISION-LOCATION		ECN	DATE
	S/N		Sales Engineer C.C.	Application Engineer R.C.		BY C. RACHAL	APPROVED
Project Title						PURCHASE ORDER NUMBER	
DUPLEX PUMP CONTROL PANEL						DRAWING NUMBER CP-2119R1	
						SHEET NUMBER	
						4	

NEMA 4X FIBERGLASS ENCLOSURE

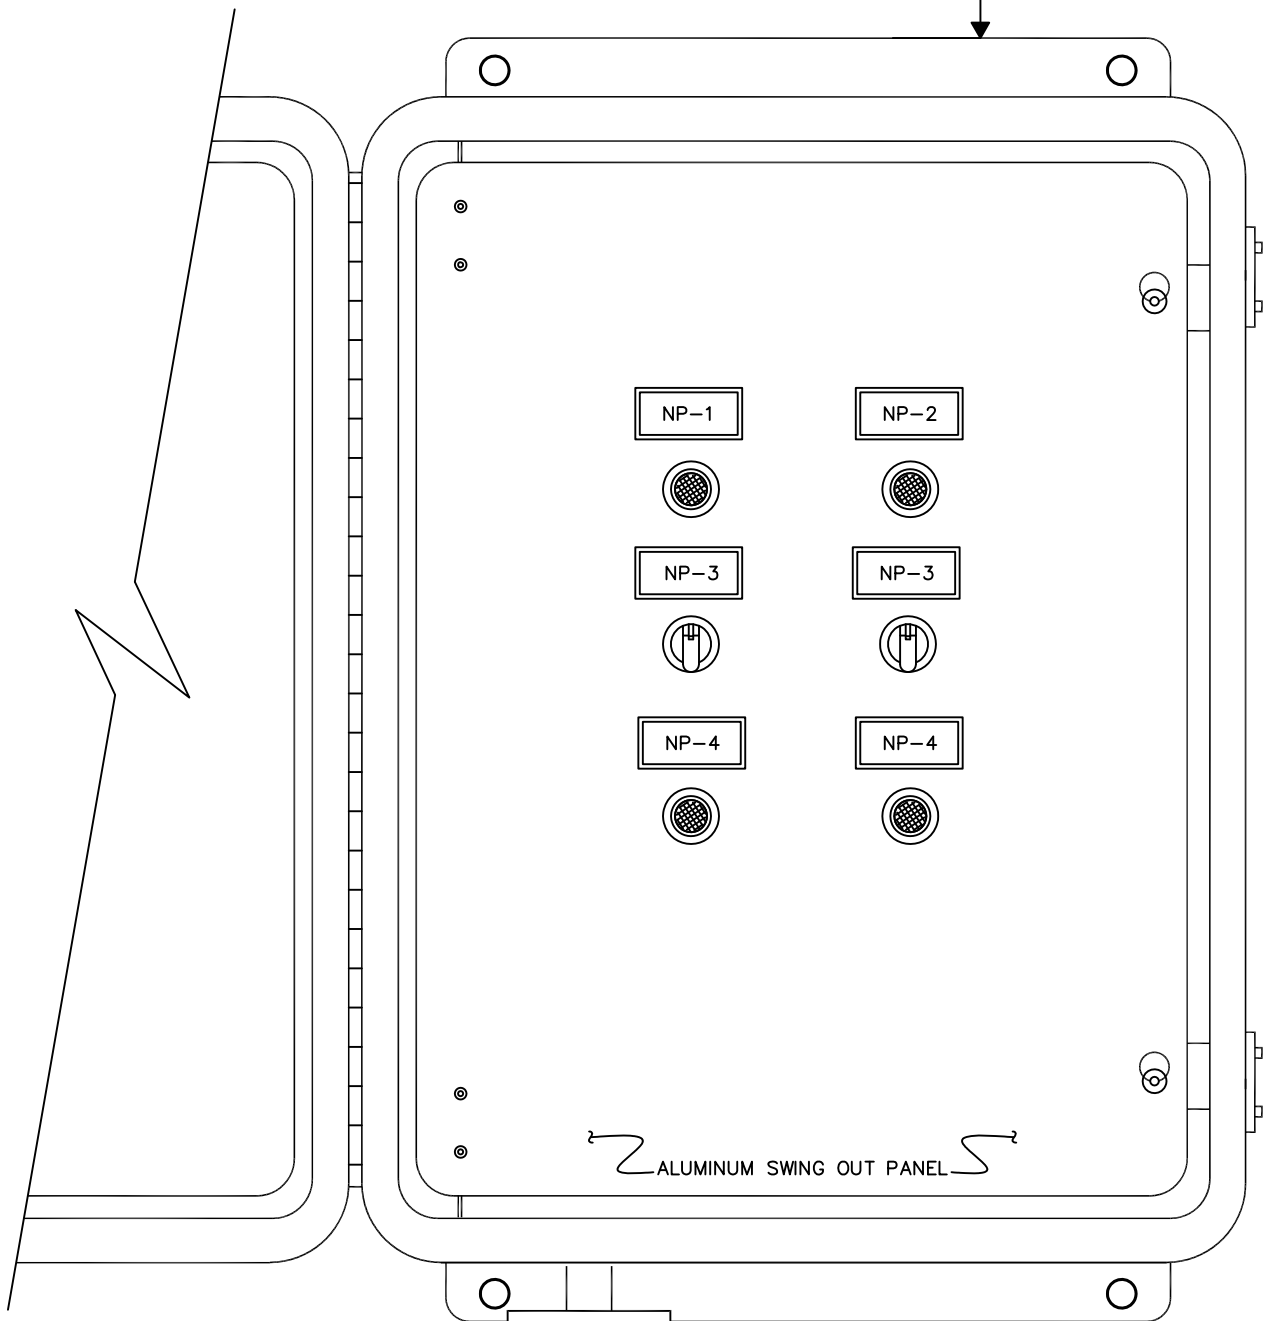


ALUMINUM SWING OUT PANEL

VIEW OF SWING OUT PANEL

NAMEPLATE SCHEDULE

NP-1	PUMP 1/RUN
NP-2	PUMP 2/RUN
NP-3	HOA
NP-4	SEAL FAIL

NOTE:  
SEWER GASSES WILL DESTROY COMPONENTS IN PANEL.  
PROPER SEALS MUST BE INSTALLED EXTERNAL TO THE  
PANEL TO PREVENT ENTRY OF GASSES.

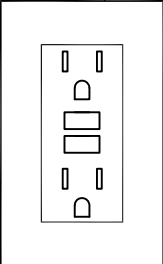

Drawing Title							
ENCLOSURE							
DATE 8/01/05		REFERENCE DRAWING		NO.		REVISION-LOCATION	
		S/N		Sales Engineer C.C.		Application Engineer R.C.	
Project Title				DRAWN BY C. RACHAL		APPROVED BY DATE	
DUPLEX PUMP CONTROL PANEL				P.O. Box 77808 Baton Rouge, LA 70809		PURCHASE ORDER NUMBER	
				Ph. (225)756-3271 Fax (225)755-1030		DRAWING NUMBER CP-2119R1	
						SHEET NUMBER 5	

## BILL OF MATERIALS

ITEM	QTY	MANUFACTURER	PART NO.	DESCRIPTION	
1	1	ALLIED	AM24200RL	ENCLOSURE	*
1a	1	ALLIED	2420AL	BACKPLATE	
2	1	ABB	OT80E3	MAIN DISC. SWITCH	
3	2	ABB	AF30-30-00-13	MOTOR STARTER	
4	2	ABB	TF42-29	O.L. RELAY (24-29A)	
5	2	SQUARE D	QOU350	CB1, CB2	
6	1	DIVERSIFIED	ARB-120-ADA	ALTERNATING RELAY	
7	4	ABB	CL513R	RED PILOT LIGHT	
8	2	ABB	C3SS110B-20	HOA SWITCH	
9	1	SQUARE D	QOU130	CB4	
10	3	SQUARE D	QOU115	CB5-7	
11	1	SQUARE D	3S1F	3KVA EXTERNAL TRANSFORMER	*
12	1	STAHLIN	RJ1412HPL	J-BOX	*
13	1	MARATHON	1323580	DISTRIBUTION BLOCK	
14	2	SSAC	LLC54AA	SEAL FAIL RELAY	
15	1	SQUARE D	QOU230	CB3	
16	1	HUBBELL		GFI RECEPTACLE	*
17	1	ABB	T4150PSF-1	150VA TRANSFORMER	
18	2	COX RESEARCH	OPTI-TR2A	TRANSCEIVER	
19	4	COX RESEARCH	OPTI-F130-WT1	30' WEIGHTED OPTI-FLOAT	
20	1	COX RESEARCH	OPTI-PS1	POWER SUPPLY	
21	2	ABB	CA4-10	AUX CONTACT	
22	1	SQUARE D	QOU110	CB8	
23	1	ALLIED	HFP2420	SWING PANEL	
24					
25					

\*EXISTING

	Drawing Title						
	BILL OF MATERIALS						
DATE 8/01/05		REFERENCE DRAWING S/N	NO. Sales Engineer C.C.	REVISION-LOCATION Application Engineer R.C.	DRAWN BY C. RACHAL	ECN	DATE
	Project Title	<div style="border: 1px solid black; padding: 5px; margin: 0 auto; width: 150px;"> <b>COX</b>  <small>Research and Technology, Inc.</small> </div>			P.O. Box 77808 Baton Rouge, LA 70809  Ph. (225)756-3271 Fax (225)755-1030		PURCHASE ORDER NUMBER  DRAWING NUMBER CP-2119R1 SHEET NUMBER 6
	DUPLEX PUMP CONTROL PANEL						