

---

---

COX

Research and Technology, Inc.

---

---


CS1/LS2  
DUPLEX PUMP  
CONTROL PANEL

AS BUILTS

SEPTEMBER 28, 2012

Cox Research and Technology, Inc.  
14697 S. Harrells Ferry Road  
Baton Rouge, LA. 70816  
(225) 756-3271 Fax (225) 755-1030



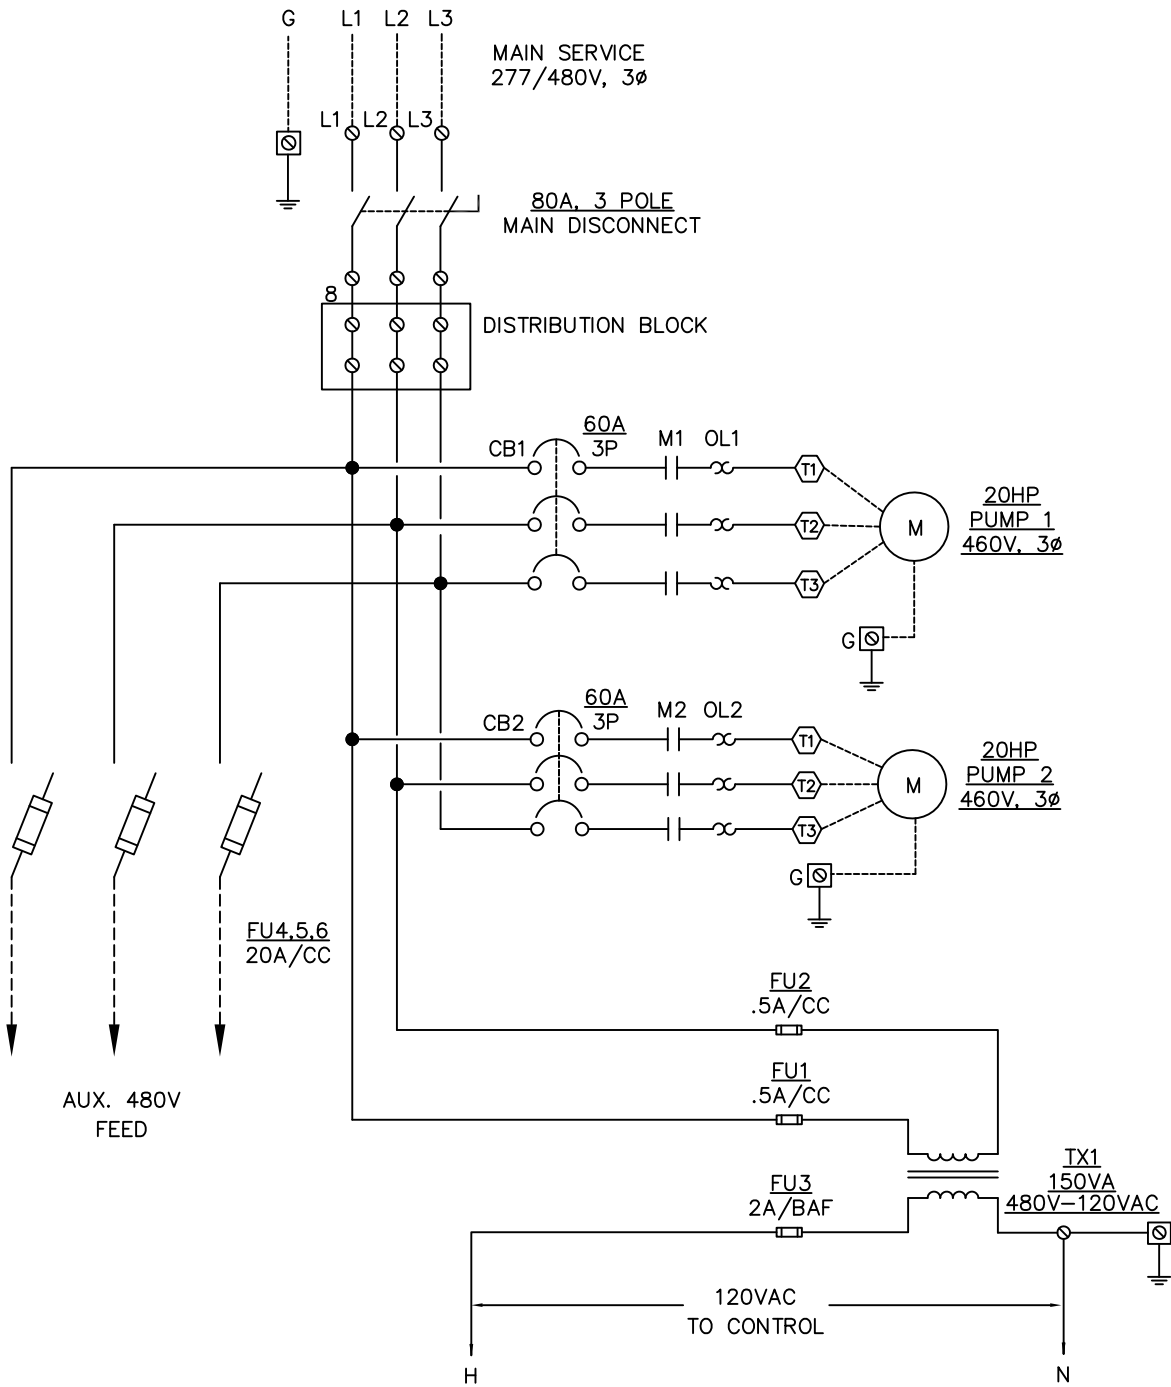


	Drawing Title								
	POWER DIAGRAM								
DATE	09/21/12	REFERENCE DRAWING	NO.	REVISION-LOCATION	ECN	DATE	BY	APPROVED	
		S/N	Sales Engineer	Application Engineer	BY E. ECKER	BY	DATE		
	Project Title							PURCHASE ORDER NUMBER	
	STOLTHAVEN							DRAWING NUMBER	
								CP-1239r1	
								SHEET NUMBER	2

**COX**

Research and Technology, Inc.

P.O. Box 77808  
Baton Rouge, LA  
70879

Ph. (225)756-3271  
Fax (225)755-1030

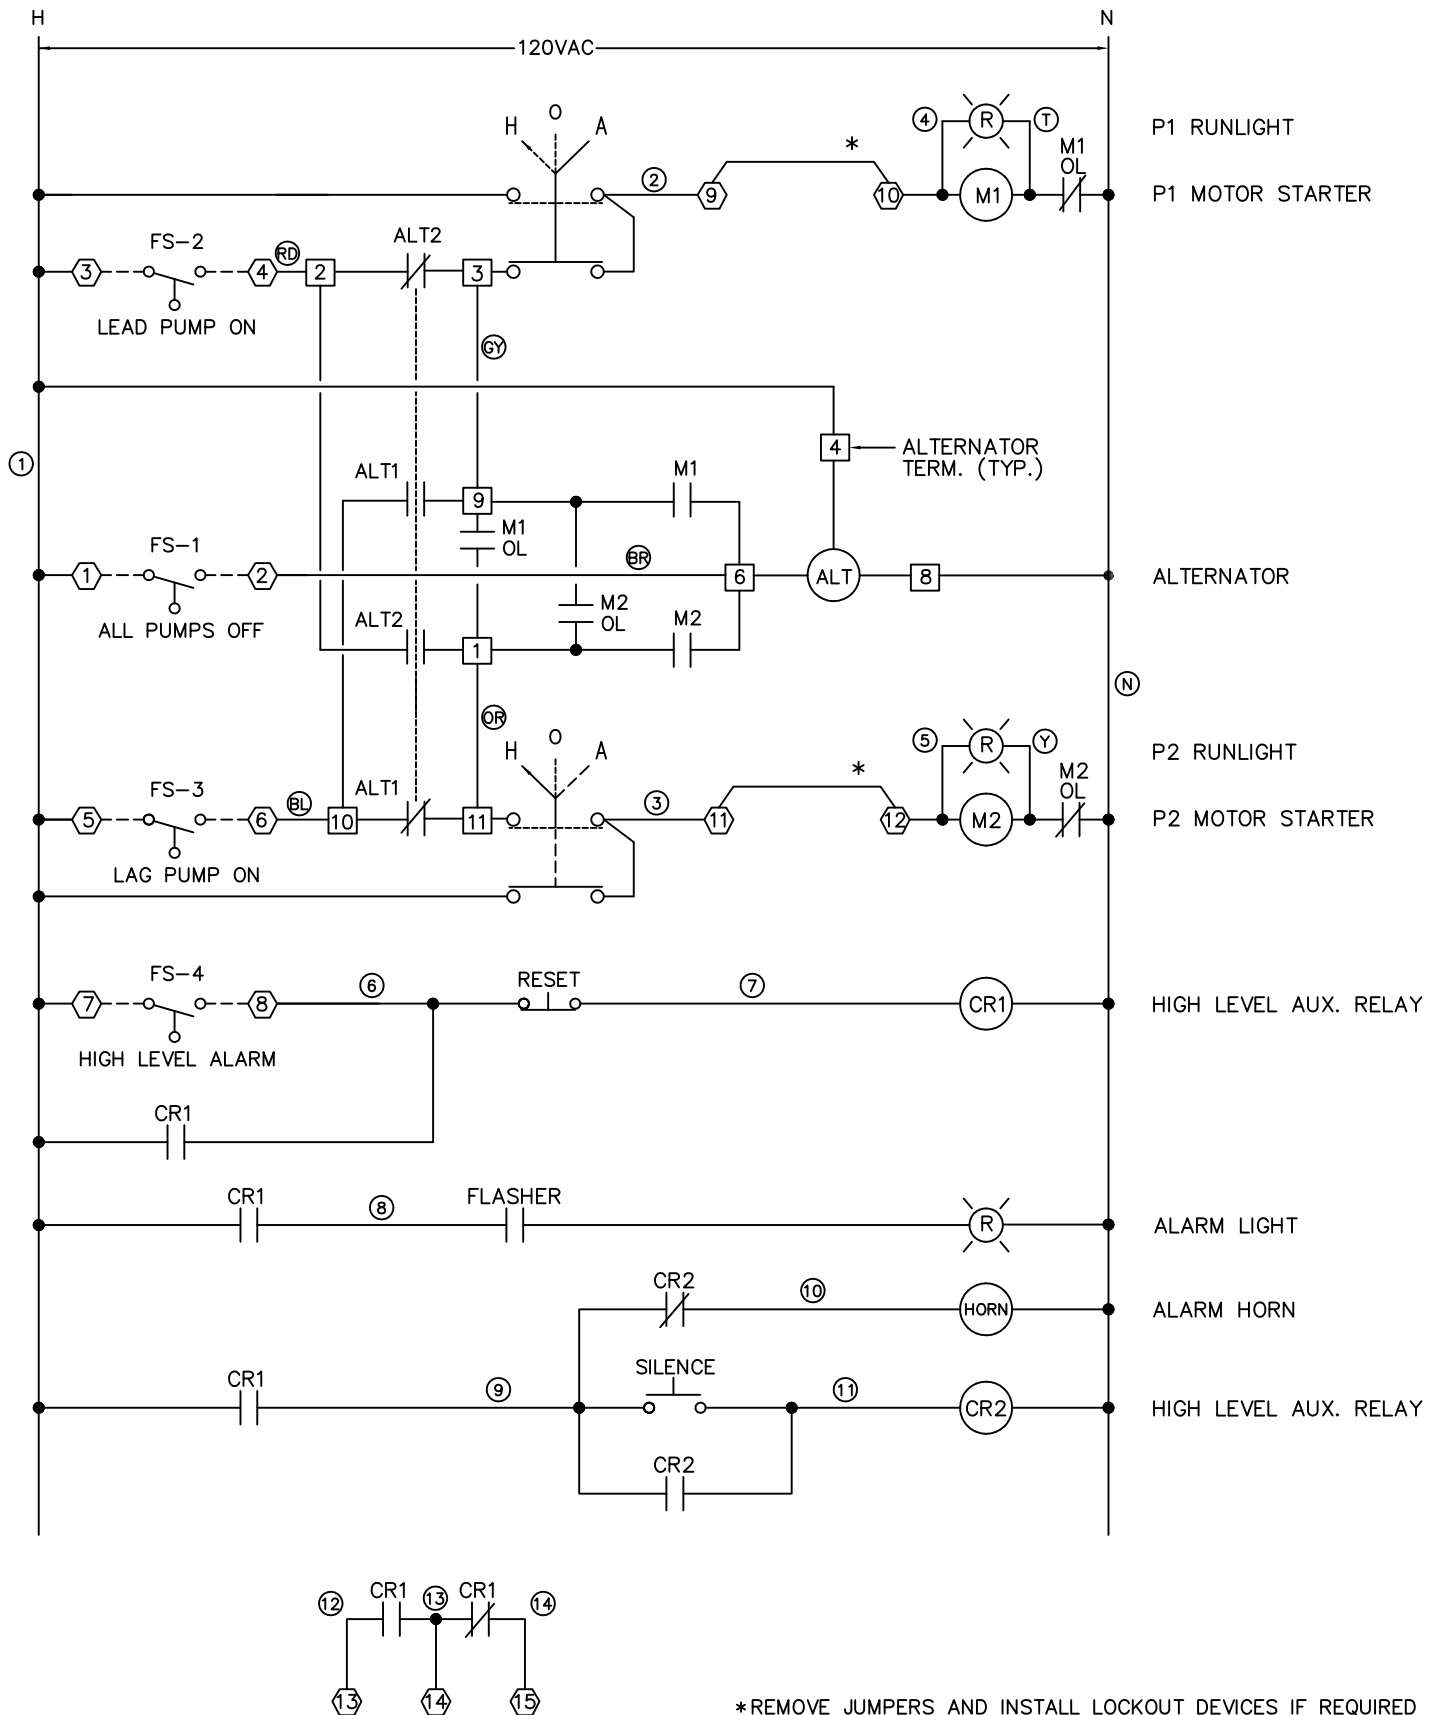


	Drawing Title								
	CONTROL DIAGRAM								
DATE	09/21/12	REFERENCE DRAWING	NO.	REVISION-LOCATION	ECN	DATE	BY	APPROVED	
		S/N	Sales Engineer	Application Engineer	BY E. ECKER	DATE			
	Project Title							PURCHASE ORDER NUMBER	
	STOLTHAVEN							DRAWING NUMBER	CP-1239r1
								SHEET NUMBER	3

**COX**

Research and Technology, Inc.

P.O. Box 77808  
Baton Rouge, LA  
70879

Ph. (225)756-3271  
Fax (225)755-1030

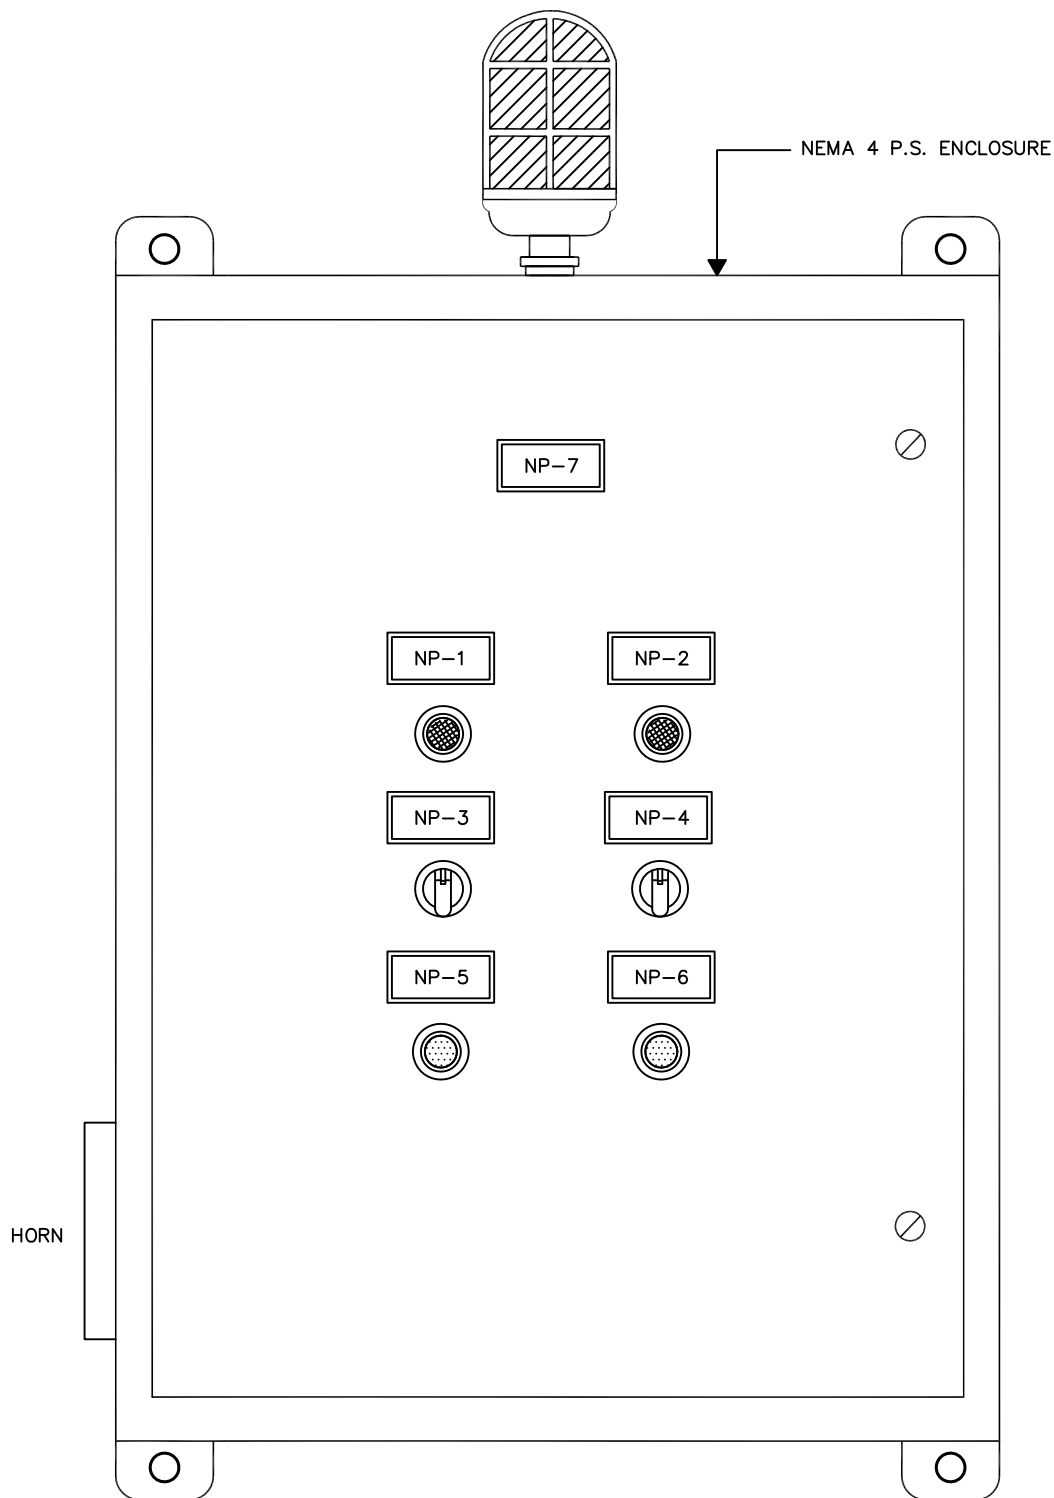

VIEW OF FRONT DOOR OF PANEL

NAMEPLATE SCHEDULE

NP-1	PUMP 1/RUN
NP-2	PUMP 2/RUN
NP-3	HOA
NP-4	HOA
NP-5	ALARM SILENCE
NP-6	RESET
NP-7	CS1/LS2

NOTE:  
SEWER GASSES WILL DESTROY COMPONENTS IN PANEL.  
PROPER SEALS MUST BE INSTALLED EXTERNAL TO THE  
PANEL TO PREVENT ENTRY OF GASSES.

	Drawing Title								
	ENCLOSURE								
DATE		REFERENCE DRAWING	NO.	REVISION-LOCATION	ECN	DATE	BY		
09/21/12		S/N	Sales Engineer	Application Engineer					
	Project Title			T.L.	BY E. ECKER		APPROVED		
	STOLTHAVEN						DATE		
							PURCHASE ORDER NUMBER		
							DRAWING NUMBER		
							CP-1239r1		
							SHEET NUMBER		
									4

COX

Research and Technology, Inc.

P.O. Box 77808  
Baton Rouge, LA  
70879

Ph. (225)756-3271  
Fax (225)755-1030

# BILL OF MATERIALS

ITEM	QTY	MANUFACTURER	PART NO.	DESCRIPTION
1	1	SAGINAW	SCE-30EL2408LP	ENCLOSURE
1a	1	SAGINAW	SCE-30P24	BACKPLATE
2	1	ABB	OT80F3	DISCONNECT SWITCH
3	2	ABB	T1N060TL	CB1,2
4	2	ABB	A26-30-10-84	MOTOR STARTER
5	2	ABB	TA25DU32	OL RELAY (24-32A)
6	3	PHOENIX	3048580	FUSE HOLDER
7	1	DIVERSIFIED	ARB-120-ADA	ALTERNATING RELAY
8	1	SSAC	FS126RC	FLASHER
9	2	ABB	CL513R	RED LED PILOT
10	2	ABB	C3SS110B-20	HOA SWITCH
11	1	ABB	X4150PSF-1	TRANSFORMER
12	2	ABB	CP110B-11	PUSH BUTTON
13	2	IDEC	RY4SULAC120	CR1,2
14	1	CONERY	RA-A-VP100RDG	ALARM LIGHT
15	1	EDWARD SIGNAL	870P-N5	HORN
16	1	MARATHON	1323580	DISTRIBUTION BLOCK
17				
18				
19				
20				
21				
22				
23				
24				

	Drawing Title						
	<h2 style="margin: 0;">BILL OF MATERIALS</h2>						
DATE 09/21/12		REFERENCE DRAWING S/N	NO. Sales Engineer	REVISION-LOCATION Application Engineer T.L.	DRAWN BY E. ECKER	ECN	DATE
	Project Title	<div style="border: 1px solid black; padding: 5px; margin: 0 auto; width: 150px;"> <h1 style="margin: 0;">COX</h1> <p style="margin: 0;">Research and Technology, Inc.</p> </div>			P.O. Box 77808 Baton Rouge, LA 70879  Ph. (225)756-3271 Fax (225)755-1030		PURCHASE ORDER NUMBER  DRAWING NUMBER CP-1239r1 SHEET NUMBER <div style="text-align: right;">5</div>
	STOLTHAVEN						