
COX


Research and Technology, Inc.


PANEL LP3
LIGHTING
CONTROL PANEL

AS BUILTS


SEPTEMBER 28, 2012

Cox Research and Technology, Inc.
14697 S. Harrells Ferry Road
Baton Rouge, LA. 70816
(225) 756-3271 Fax (225) 755-1030

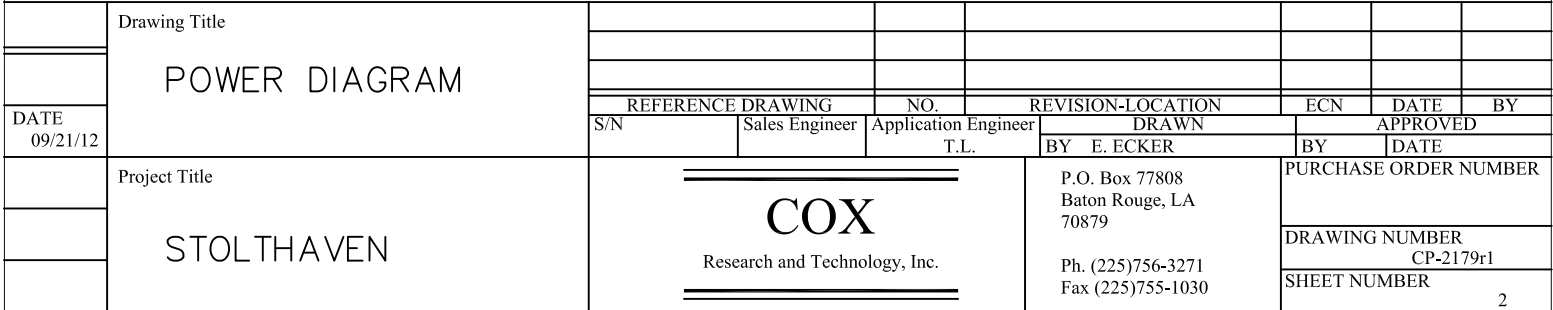

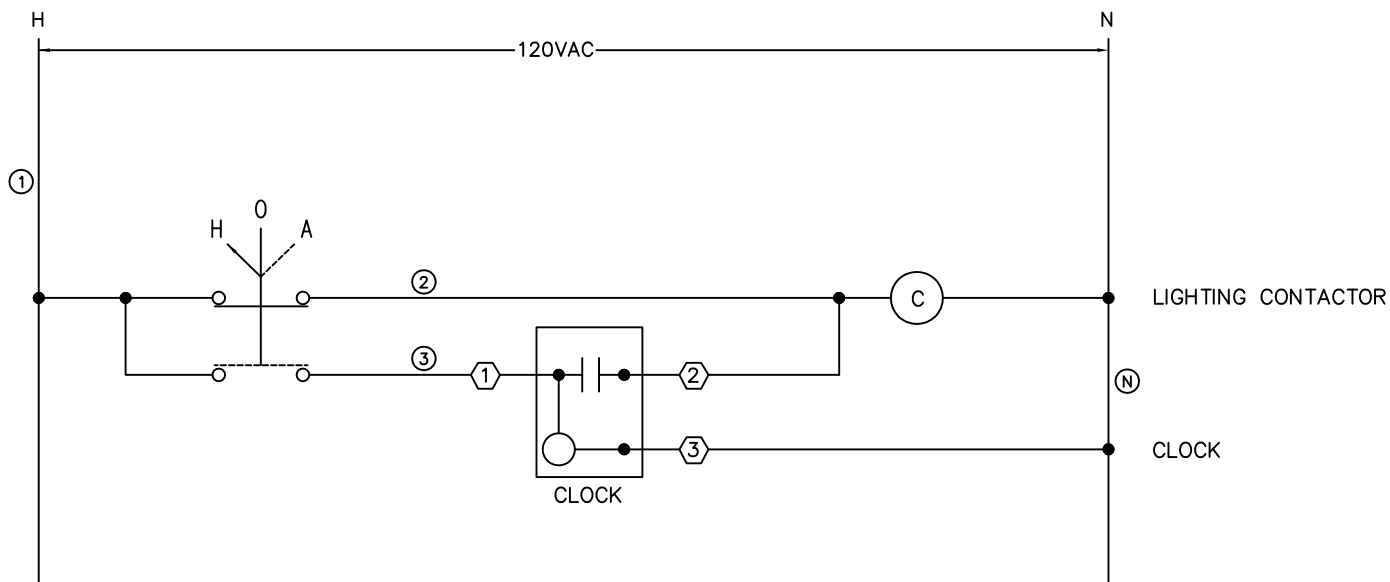

	Drawing Title							
	CONTROL DIAGRAM							
DATE 09/21/12		REFERENCE DRAWING S/N	NO. Sales Engineer	REVISION-LOCATION Application Engineer T.L.	DRAWN BY E. ECKER	ECN BY	DATE DATE	BY
	Project Title	<div><div>COX</div><div>Research and Technology, Inc.</div></div>			P.O. Box 77808 Baton Rouge, LA 70879	PURCHASE ORDER NUMBER		
	STOLTHAVEN				Ph. (225)756-3271 Fax (225)755-1030	DRAWING NUMBER CP-2179r1		
						SHEET NUMBER 3		

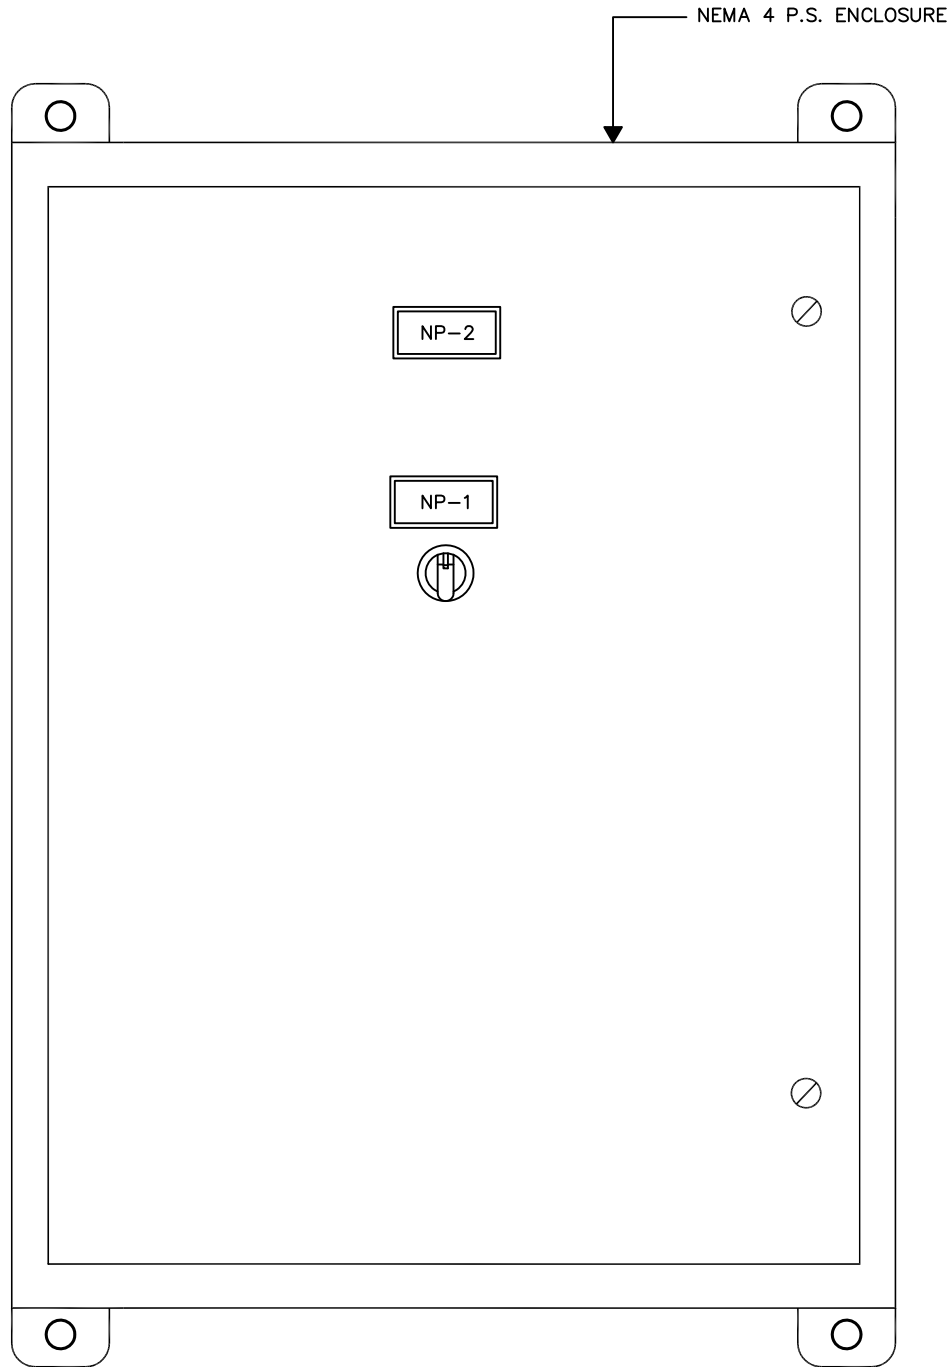

VIEW OF FRONT DOOR OF PANEL

NAMEPLATE SCHEDULE

NP-1 HOA
NP-2 LIGHTING CONTACTOR
PANEL LP3

NOTE:
SEWER GASSES WILL DESTROY COMPONENTS IN PANEL.
PROPER SEALS MUST BE INSTALLED EXTERNAL TO THE
PANEL TO PREVENT ENTRY OF GASSES.

	Drawing Title						
	ENCLOSURE						
DATE		REFERENCE DRAWING	NO.	REVISION-LOCATION	ECN	DATE	BY
09/21/12		S/N	Sales Engineer	Application Engineer			
	Project Title			T.L.	BY E. ECKER	BY	DATE
	STOLTHAVEN	<div style="text-align: center;"> COX Research and Technology, Inc. </div>			P.O. Box 77808 Baton Rouge, LA 70879 Ph. (225)756-3271 Fax (225)755-1030	PURCHASE ORDER NUMBER DRAWING NUMBER CP-2179r1 SHEET NUMBER 4	

BILL OF MATERIALS

ITEM	QTY	MANUFACTURER	PART NO.	DESCRIPTION
1	1	SAGINAW	SCE-16EL1408LP	ENCLOSURE
1a	1	SAGINAW	SCE-16P14	BACKPLATE
2	1	ABB	T1N040TL	CB1
3	1	ABB	A50-30-11-84	CONTACTOR
4	1	ABB	X4150PSF-1	CPT
5	1	ABB	C3SS110B-20	HOA SWITCH
6	1	GRASSLIN	FM1/STUZZ	CLOCK
7				
8				
	Drawing Title						
	<h2 style="margin: 0;">BILL OF MATERIALS</h2>						
DATE		REFERENCE DRAWING	NO.	REVISION-LOCATION	ECN	DATE	BY
09/21/12		S/N	Sales Engineer	Application Engineer			
	Project Title	<div style="border-top: 3px double black; border-bottom: 3px double black; padding: 5px 0;"> <h1 style="margin: 0;">COX</h1> </div> <div style="font-size: small; margin-top: 5px;">Research and Technology, Inc.</div>			P.O. Box 77808 Baton Rouge, LA 70879 Ph. (225)756-3271 Fax (225)755-1030		PURCHASE ORDER NUMBER DRAWING NUMBER CP-2179r1 SHEET NUMBER
	<h2 style="margin: 0;">STOLTHAVEN</h2>						
		5					