

---

---

COX

Research and Technology, Inc.

---

---


PANEL LP2  
LIGHTING  
CONTROL PANEL

AS BUILTS


SEPTEMBER 28, 2012

Cox Research and Technology, Inc.  
14697 S. Harrells Ferry Road  
Baton Rouge, LA. 70816  
(225) 756-3271 Fax (225) 755-1030



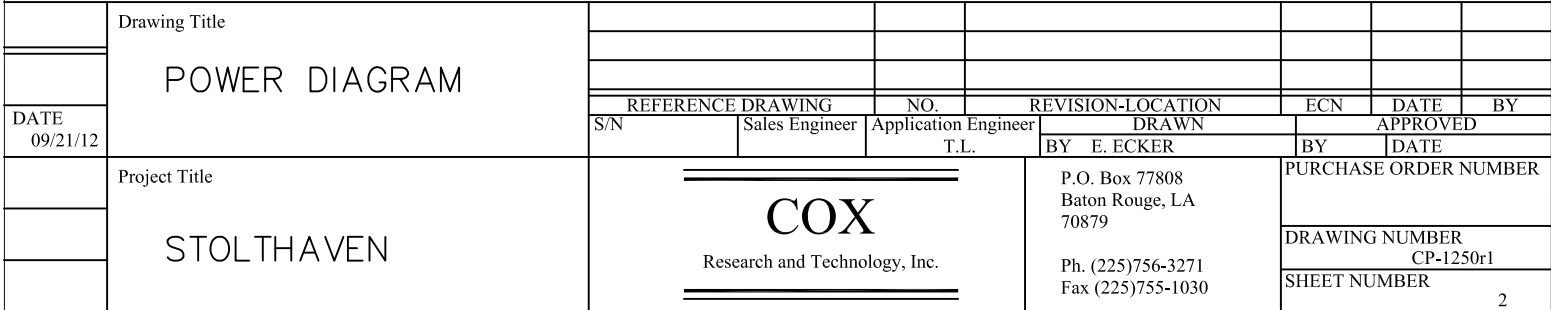



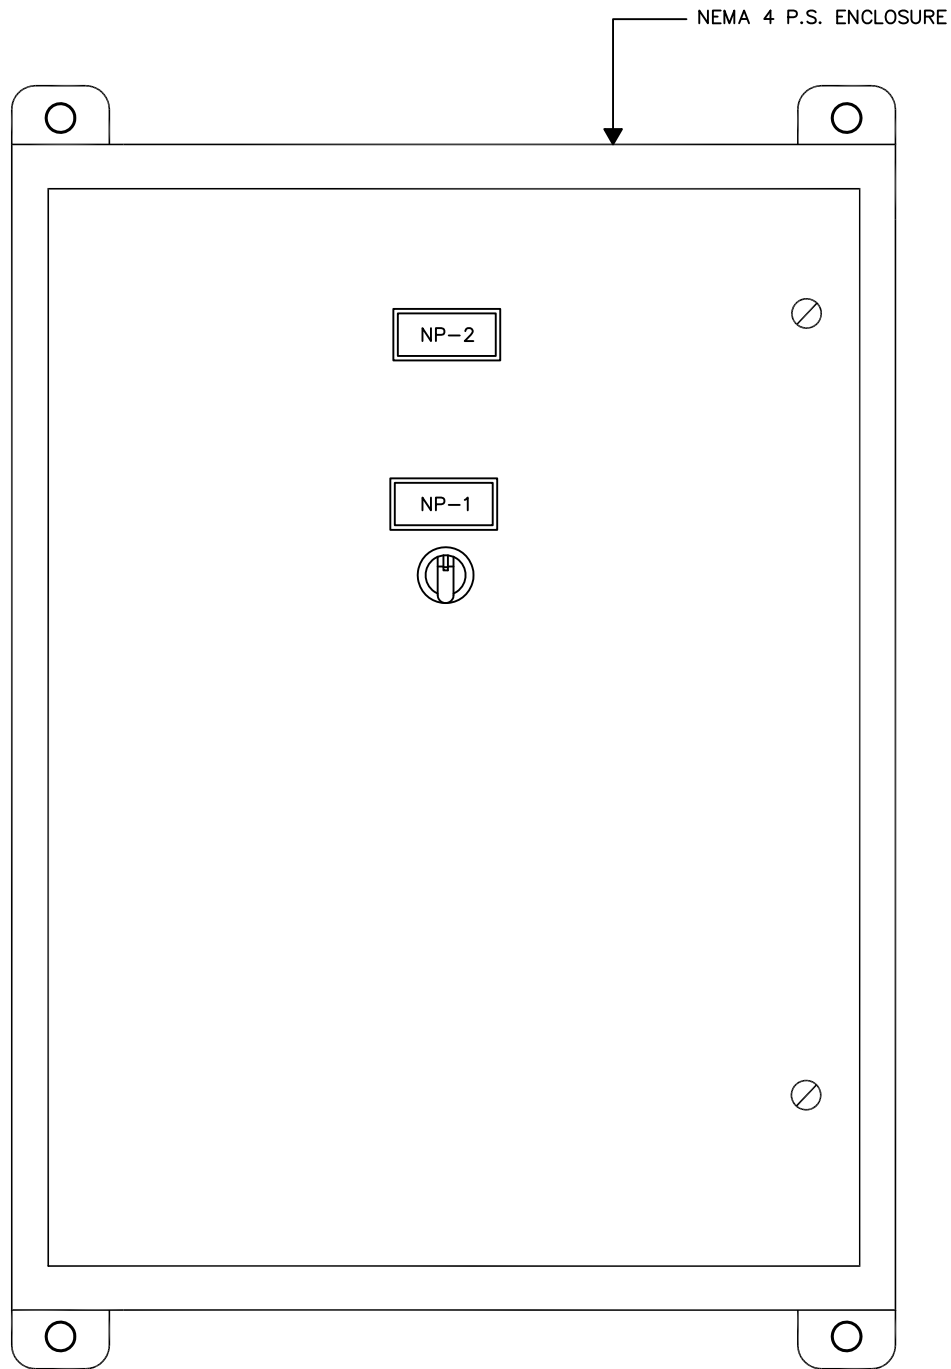

VIEW OF FRONT DOOR OF PANEL

NAMEPLATE SCHEDULE

NP-1 HOA  
NP-2 LIGHTING CONTACTOR  
PANEL LP2

**NOTE:**  
SEWER GASSES WILL DESTROY COMPONENTS IN PANEL.  
PROPER SEALS MUST BE INSTALLED EXTERNAL TO THE  
PANEL TO PREVENT ENTRY OF GASSES.

	Drawing Title						
	ENCLOSURE						
DATE		REFERENCE DRAWING	NO.	REVISION-LOCATION	ECN	DATE	BY
09/21/12		S/N	Sales Engineer	Application Engineer			
	Project Title			T.L.	BY E. ECKER	BY	DATE
	STOLTHAVEN	<div style="text-align: center;"> <b>COX</b>  Research and Technology, Inc. </div>			P.O. Box 77808 Baton Rouge, LA 70879  Ph. (225)756-3271 Fax (225)755-1030	PURCHASE ORDER NUMBER  DRAWING NUMBER CP-1250r1 SHEET NUMBER 4	

# BILL OF MATERIALS

ITEM	QTY	MANUFACTURER	PART NO.	DESCRIPTION
1	1	SAGINAW	SCE-16EL1408LP	ENCLOSURE
1a	1	SAGINAW	SCE-16P14	BACKPLATE
2	1	ABB	T1N040TL	CB1
3	1	ABB	A50-30-11-84	CONTACTOR
4	1	ABB	X4150PSF-1	CPT
5	1	ABB	C3SS110B-20	HOA SWITCH
6	1	GRASSLIN	FM1/STUZZ	CLOCK
7				
8				
	Drawing Title						
	<h2 style="margin: 0;">BILL OF MATERIALS</h2>						
DATE		REFERENCE DRAWING	NO.	REVISION-LOCATION	ECN	DATE	BY
09/21/12		S/N	Sales Engineer	Application Engineer			
	Project Title	<div style="border-top: 3px double black; border-bottom: 3px double black; padding: 5px;"> <h1 style="margin: 0;">COX</h1> <p style="margin: 0;">Research and Technology, Inc.</p> </div>			P.O. Box 77808 Baton Rouge, LA 70879  Ph. (225)756-3271 Fax (225)755-1030		PURCHASE ORDER NUMBER  DRAWING NUMBER CP-1250r1 SHEET NUMBER
	STOLTHAVEN						5