






Delta Environmental Products

CP-1818-12-2HP
FOR
CP-12460-3-12-2HP

AS BUILTS

OCTOBER 27, 2017

Delta Environmental
8263 Florida Blvd. Denham Springs, La 70726
225-665-6162

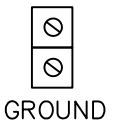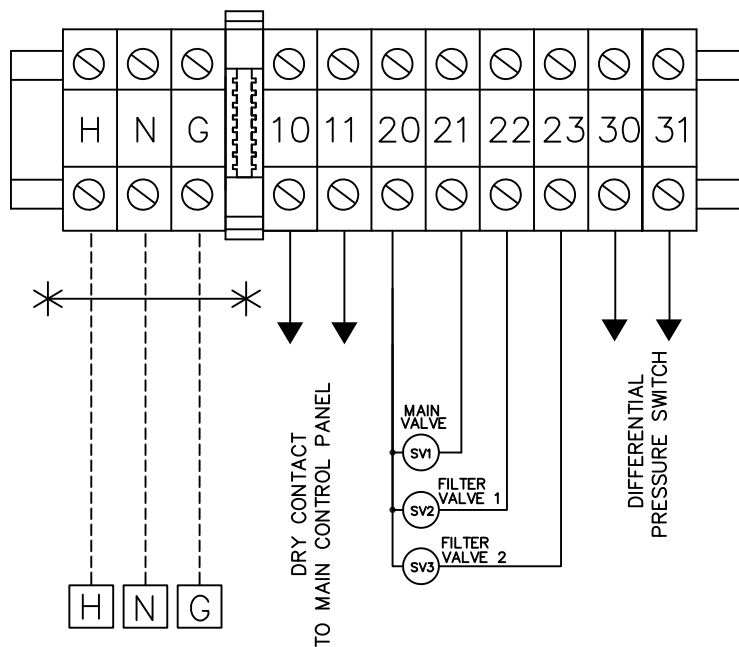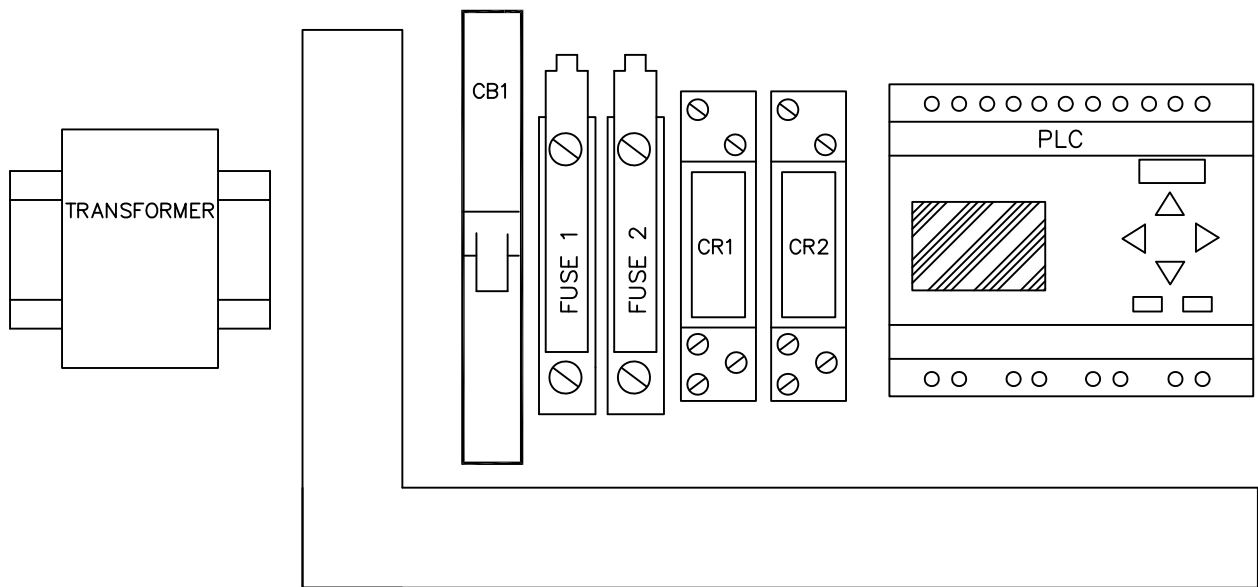

120V AC FROM
CP-12460-3-12-2HP



Delta Environmental Products
P.O. Box 969 Denham Springs, LA 70727

DWN BY:
A.F./E.C.K.


DATE:
10/27/2017

SCALE:
NTS

DWG. NO.:

JOB NO.:
CP-1818/12/2HP

External Connections Dual Disc. Filter Backwash Control Panel

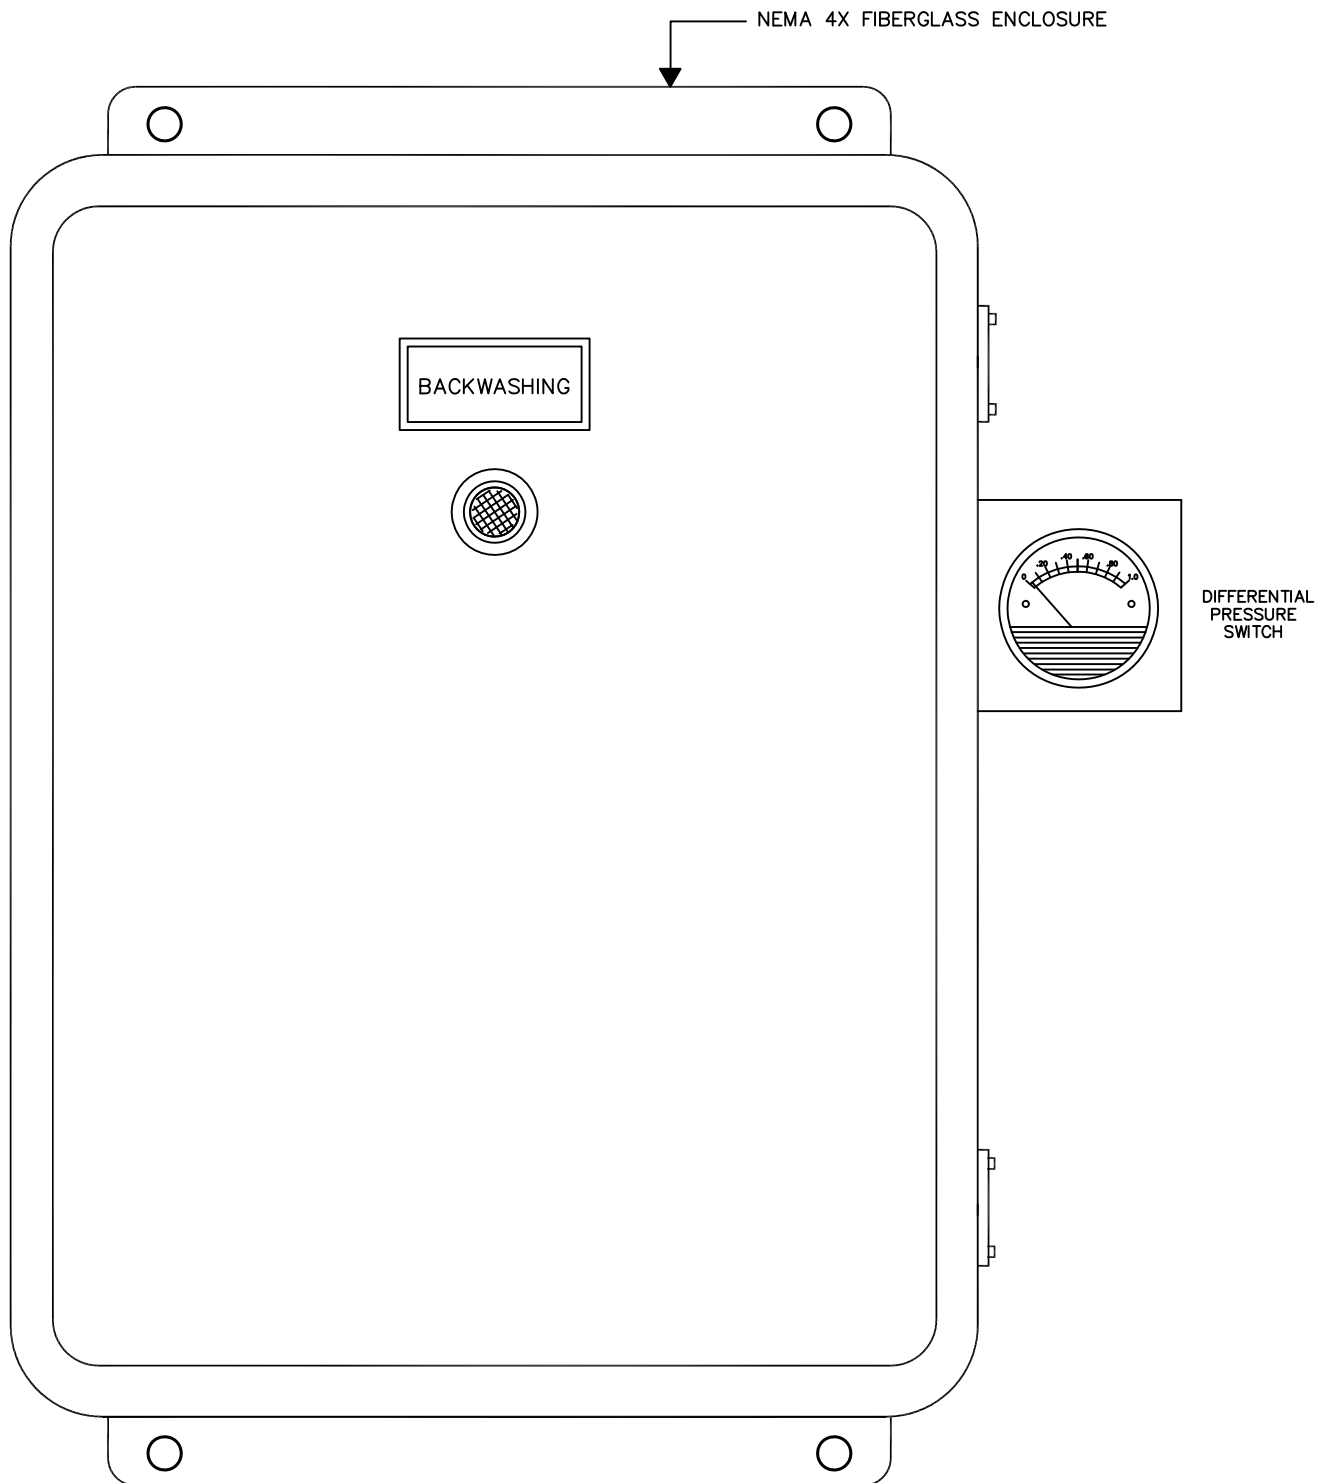

VIEW OF FRONT OF PANEL

NOTE:
SEWER GASSES WILL DESTROY COMPONENTS IN PANEL.
PROPER SEALS MUST BE INSTALLED EXTERNAL TO THE
PANEL TO PREVENT ENTRY OF GASSES.



Delta Environmental Products
P.O. Box 969 Denham Springs, LA 70727

Enclosure
Dual Disc. Filter
Backwash Control Panel

DWN BY:
A.F./E.C.K.

DATE:
10/27/2017

SCALE:
NTS

DWG. NO.:

JOB NO.:
CP-1818/12/2HP

BILL OF MATERIAL

ITEM	QTY	MANUFACTURER	PART NO.	DESCRIPTION
1	1	STAHLIN	RJ1614HPL	ENCLOSURE
1a	1	STAHLIN	BP1614AL	BACKPLATE
2	1	SQUARE D	QOU115	CB1
3	2	PHOENIX	UT4 HESI	FUSE 1,2
4	2	IDEC	RY2SULCAC24	CR1,2
5	1	SEIMENS	OBA8	PLC
6	1	WHITE RODGERS	90T40F3	120V/24VAC TRANSFORMER
7	1	STOCK	EZ SWITCH	SWITCH
8	1	MURPHY	A20DP-K-15	DIFF PRESSURE SWITCH
9	1	EBT	511-1548	24VAC LED LIGHT
10	1	ABB	CL100-R	LED LIGHT HOLDER
11				
12				
13				
14				
15				
16				



Delta Environmental Products
P.O. Box 969 Denham Springs, LA 70727

Bill of Materials Dual Disc. Filter Backwash Control Panel

DWN BY:
A.F./E.C.K.

DATE:
10/27/2017

SCALE:
NTS

DWG. NO.:

JOB NO.:
CP-1818/12/2HP