
COX


Research and Technology, Inc.

TF/LS3 INF. PUMPS
DUPLEX PUMP
CONTROL PANEL

AS BUILTS

SEPTEMBER 28, 2012

Cox Research and Technology, Inc.
14697 S. Harrells Ferry Road
Baton Rouge, LA. 70816
(225) 756-3271 Fax (225) 755-1030

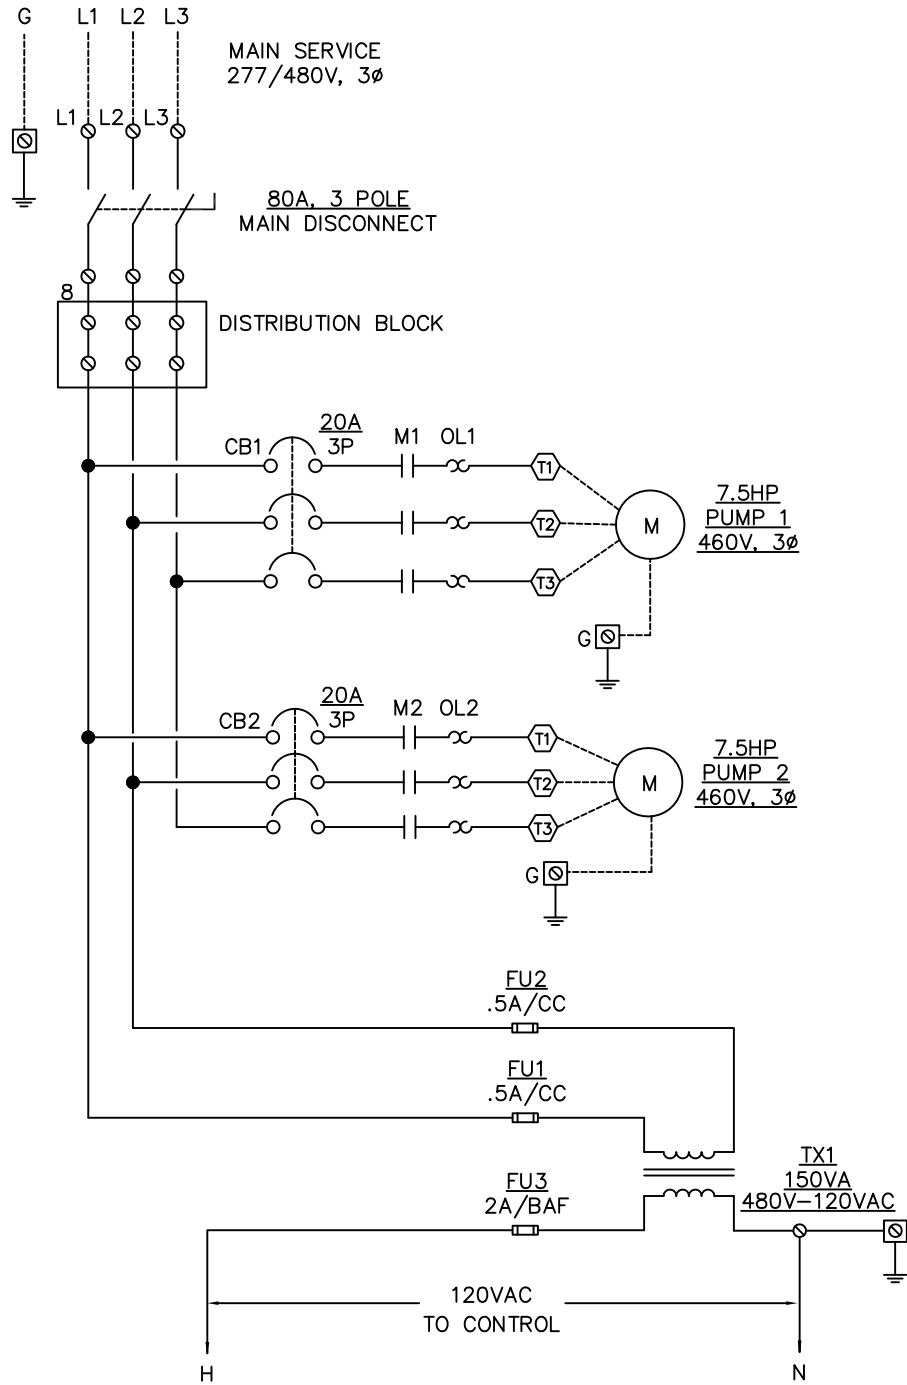


	Drawing Title							
	POWER DIAGRAM							
DATE		REFERENCE DRAWING	NO.	REVISION-LOCATION	ECN	DATE	BY	
09/21/12		S/N	Sales Engineer	Application Engineer				
	Project Title			T.L.	BY E. ECKER	APPROVED		
	STOLTHAVEN							PURCHASE ORDER NUMBER
								DRAWING NUMBER
								CP-1240r1
								SHEET NUMBER
								2

COX


Research and Technology, Inc.

P.O. Box 77808
Baton Rouge, LA
70879

Ph. (225)756-3271
Fax (225)755-1030

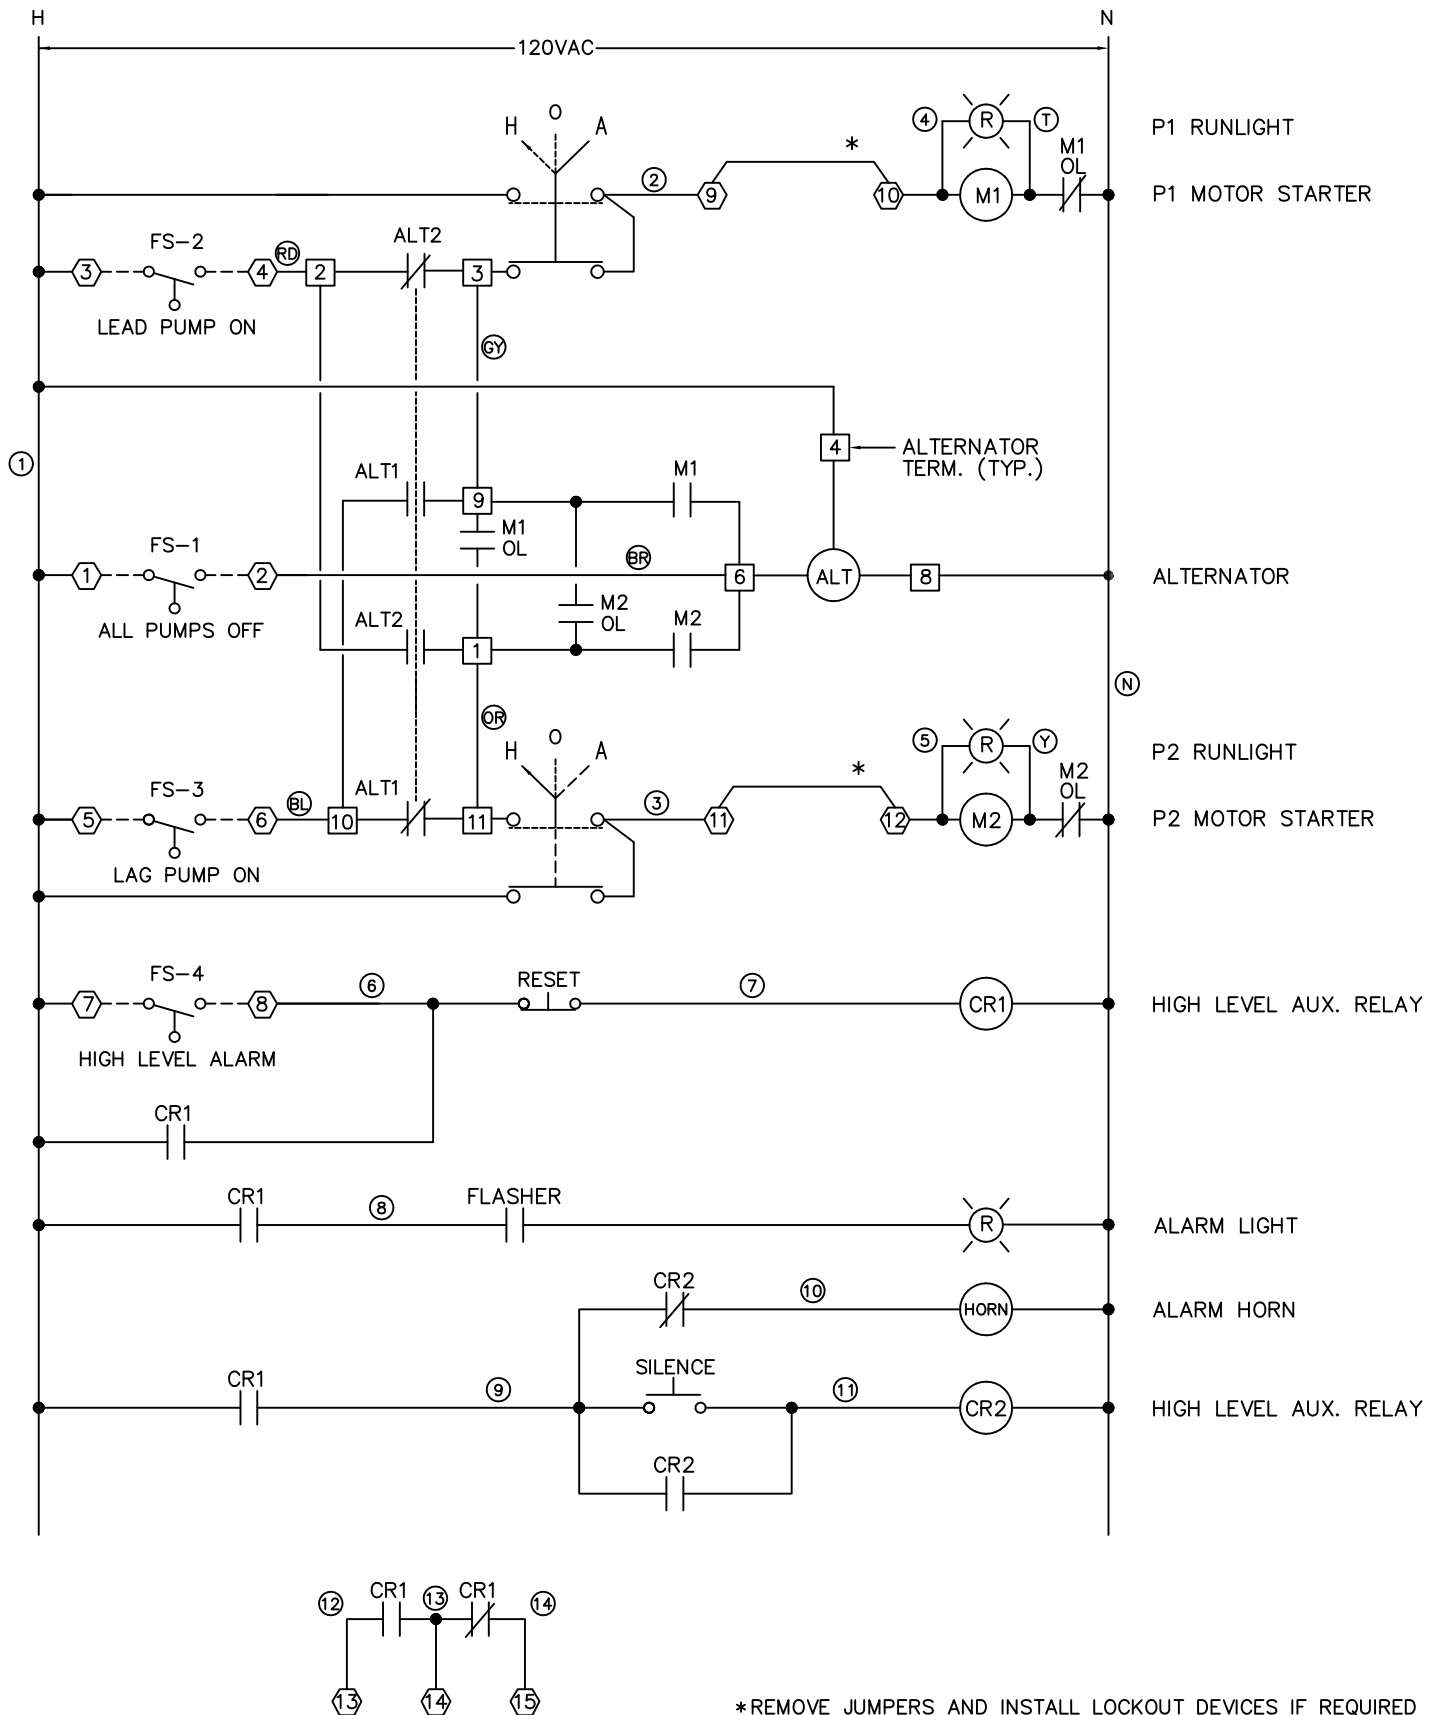

Drawing Title	CONTROL DIAGRAM					
DATE	09/21/12	REFERENCE DRAWING	NO.	REVISION-LOCATION	ECN	DATE
Project Title	STOLTHAVEN	S/N	Sales Engineer	Application Engineer	BY E. ECKER	APPROVED
		COX		P.O. Box 77808 Baton Rouge, LA 70879	PURCHASE ORDER NUMBER	
		Research and Technology, Inc.		Ph. (225)756-3271 Fax (225)755-1030	DRAWING NUMBER CP-1240r1	
					SHEET NUMBER	
					3	

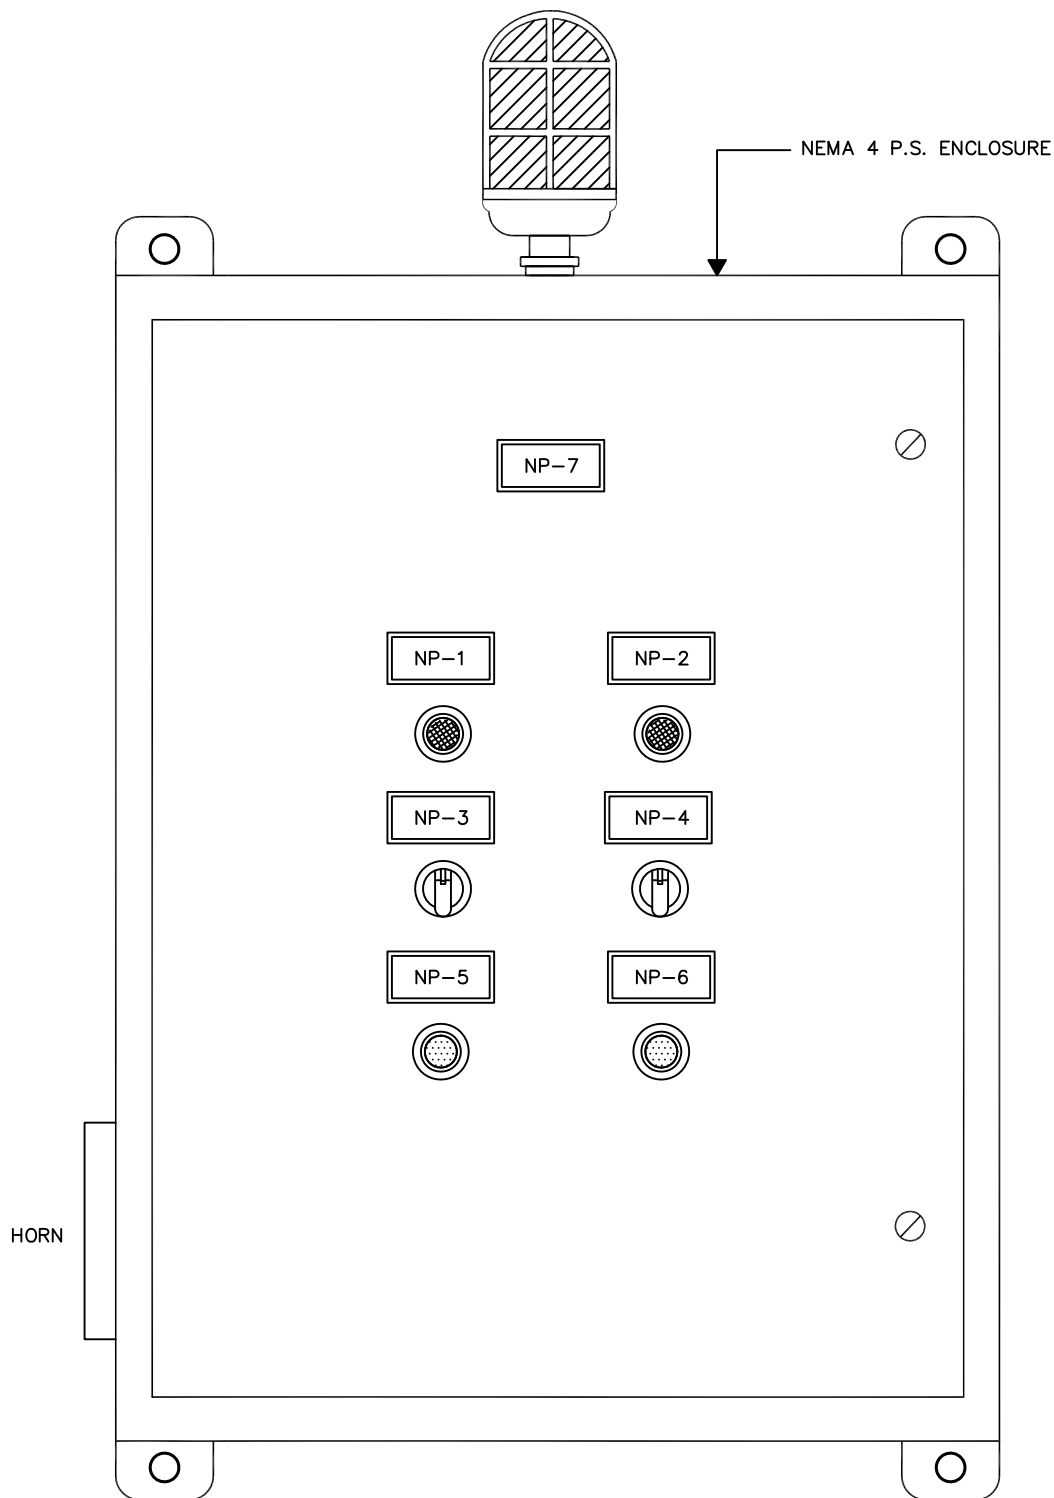

VIEW OF FRONT DOOR OF PANEL

NAMEPLATE SCHEDULE

NP-1	PUMP 1/RUN
NP-2	PUMP 2/RUN
NP-3	HOA
NP-4	HOA
NP-5	ALARM SILENCE
NP-6	RESET
NP-7	TF/LS3 INF. PUMPS

NOTE:
SEWER GASSES WILL DESTROY COMPONENTS IN PANEL.
PROPER SEALS MUST BE INSTALLED EXTERNAL TO THE
PANEL TO PREVENT ENTRY OF GASSES.

	Drawing Title								
	ENCLOSURE								
DATE		REFERENCE DRAWING	NO.	REVISION-LOCATION	ECN	DATE	BY		
09/21/12		S/N	Sales Engineer	Application Engineer					
	Project Title			T.L.	BY E. ECKER		APPROVED		
	STOLTHAVEN						DATE		
							PURCHASE ORDER NUMBER		
							DRAWING NUMBER		
							CP-1240r1		
							SHEET NUMBER		
									4

COX

Research and Technology, Inc.

P.O. Box 77808
Baton Rouge, LA
70879

Ph. (225)756-3271
Fax (225)755-1030

BILL OF MATERIALS

ITEM	QTY	MANUFACTURER	PART NO.	DESCRIPTION
1	1	SAGINAW	SCE-20EL1608LP	ENCLOSURE
1a	1	SAGINAW	SCE-20P16	BACKPLATE
2	1	ABB	OT80F3	DISCONNECT SWITCH
3	2	ABB	T1N020TL	CB1,2
4	2	ABB	A16-30-10-84	MOTOR STARTER
5	2	ABB	TA25DU14	OL RELAY (10-14A)
6	1	DIVERSIFIED	ARB-120-ADA	ALTERNATING RELAY
7	1	SSAC	FS126RC	FLASHER
8	2	ABB	CL513R	RED LED PILOT
9	2	ABB	C3SS110B-20	HOA SWITCH
10	1	ABB	X4150PSF-1	TRANSFORMER
11	2	ABB	CP110B-11	PUSH BUTTON
12	2	IDEC	RY4SULAC120	CR1,2
13	1	CONERY	RA-A-VP100RDG	ALARM LIGHT
14	1	EDWARD SIGNAL	870P-N5	HORN
15	1	MARATHON	1321580	DISTRIBUTION BLOCK
16				
17				
18				
19				
20				
21				
22				
23				
24				

	Drawing Title						
	<h2 style="margin: 0;">BILL OF MATERIALS</h2>						
DATE 09/21/12		REFERENCE DRAWING S/N	NO. Sales Engineer	REVISION-LOCATION Application Engineer T.L.	ECN	DATE	BY
	Project Title	<div style="border: 1px solid black; padding: 5px; margin: 0 auto; width: 150px;"> <h1 style="margin: 0;">COX</h1> <p style="margin: 0;">Research and Technology, Inc.</p> </div>			P.O. Box 77808 Baton Rouge, LA 70879 Ph. (225)756-3271 Fax (225)755-1030		APPROVED BY E. ECKER DATE
	<h2 style="margin: 0;">STOLTHAVEN</h2>				PURCHASE ORDER NUMBER		
					DRAWING NUMBER CP-1240r1		
					SHEET NUMBER		5