
COX


Research and Technology, Inc.

AD-1
TRIPLEX PUMP
CONTROL PANEL

AS BUILTS

SEPTEMBER 28, 2012

Cox Research and Technology, Inc.
14697 S. Harrells Ferry Road
Baton Rouge, LA. 70816
(225) 756-3271 Fax (225) 755-1030

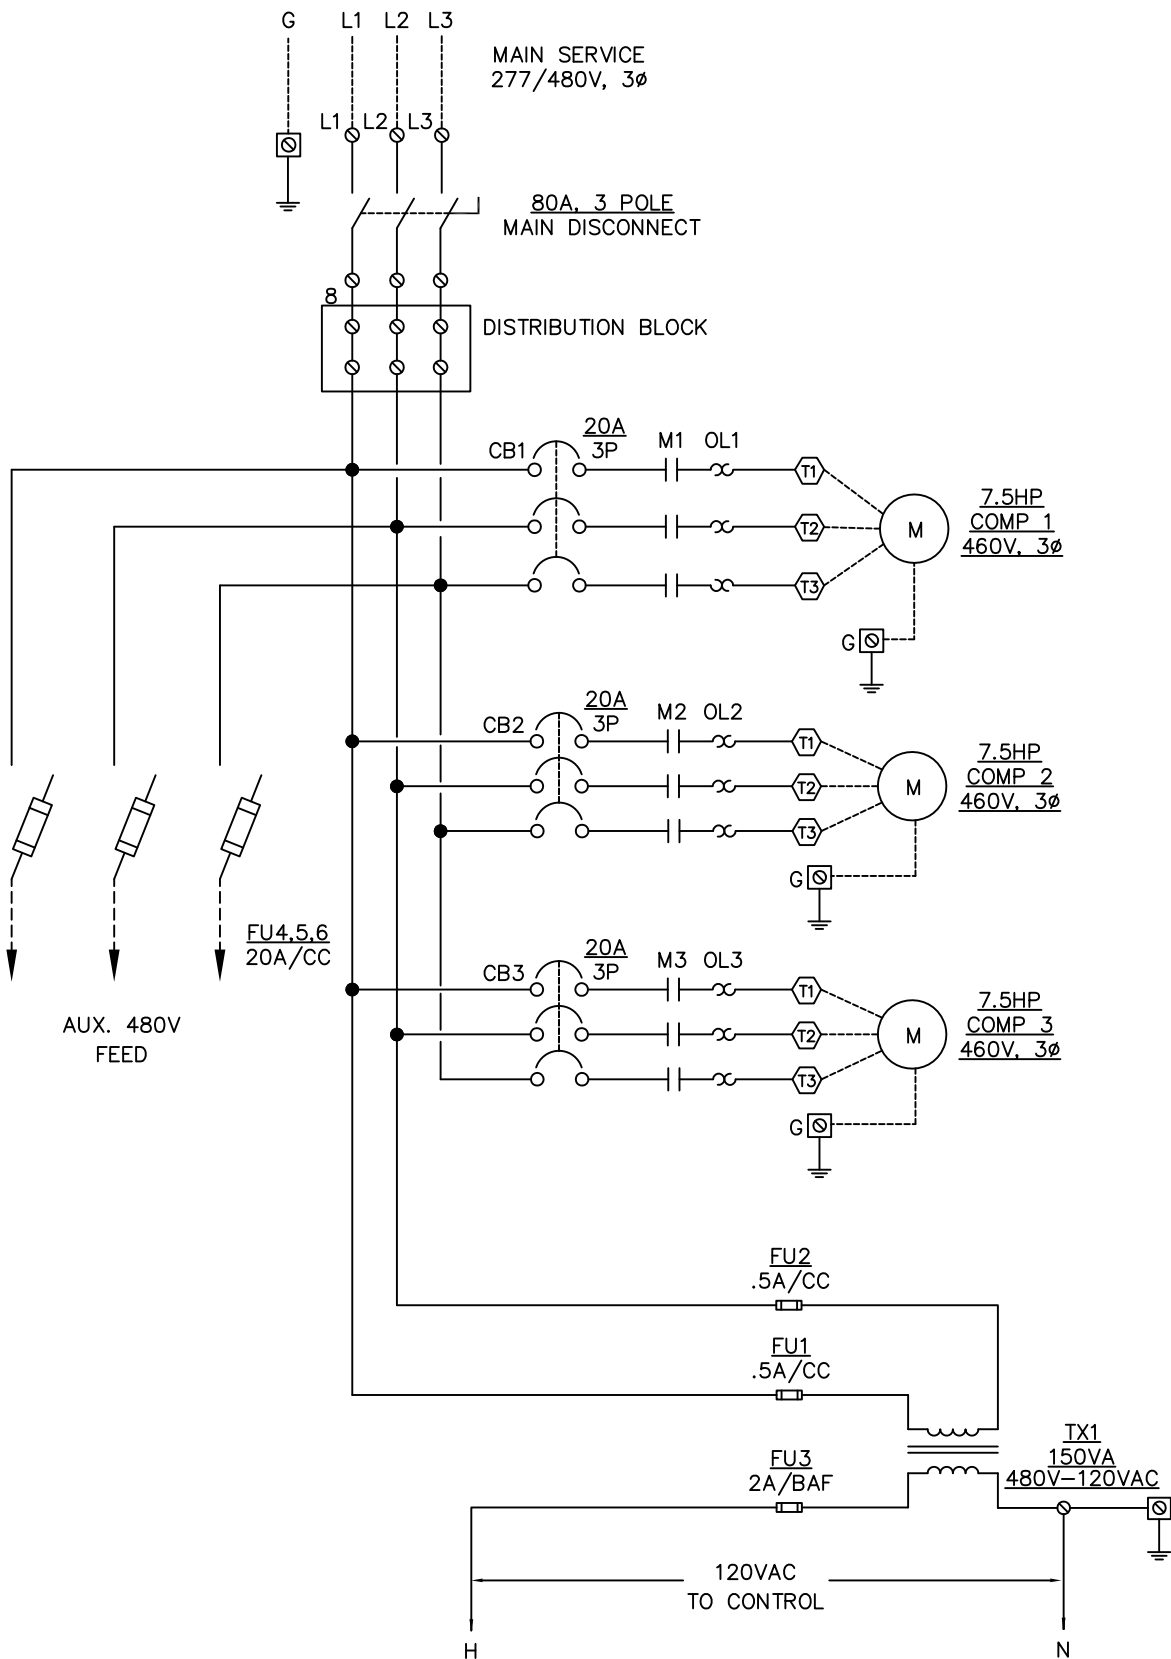


	Drawing Title								
	POWER DIAGRAM								
DATE		REFERENCE DRAWING	NO.	REVISION-LOCATION	ECN	DATE	BY		
09/21/12		S/N	Sales Engineer	Application Engineer					
	Project Title			T.L.	BY	E. ECKER	BY	DATE	
	STOLTHAVEN								PURCHASE ORDER NUMBER
									DRAWING NUMBER
									CP-1251r1
									SHEET NUMBER
									2

COX

Research and Technology, Inc.

P.O. Box 77808
Baton Rouge, LA
70879

Ph. (225)756-3271
Fax (225)755-1030

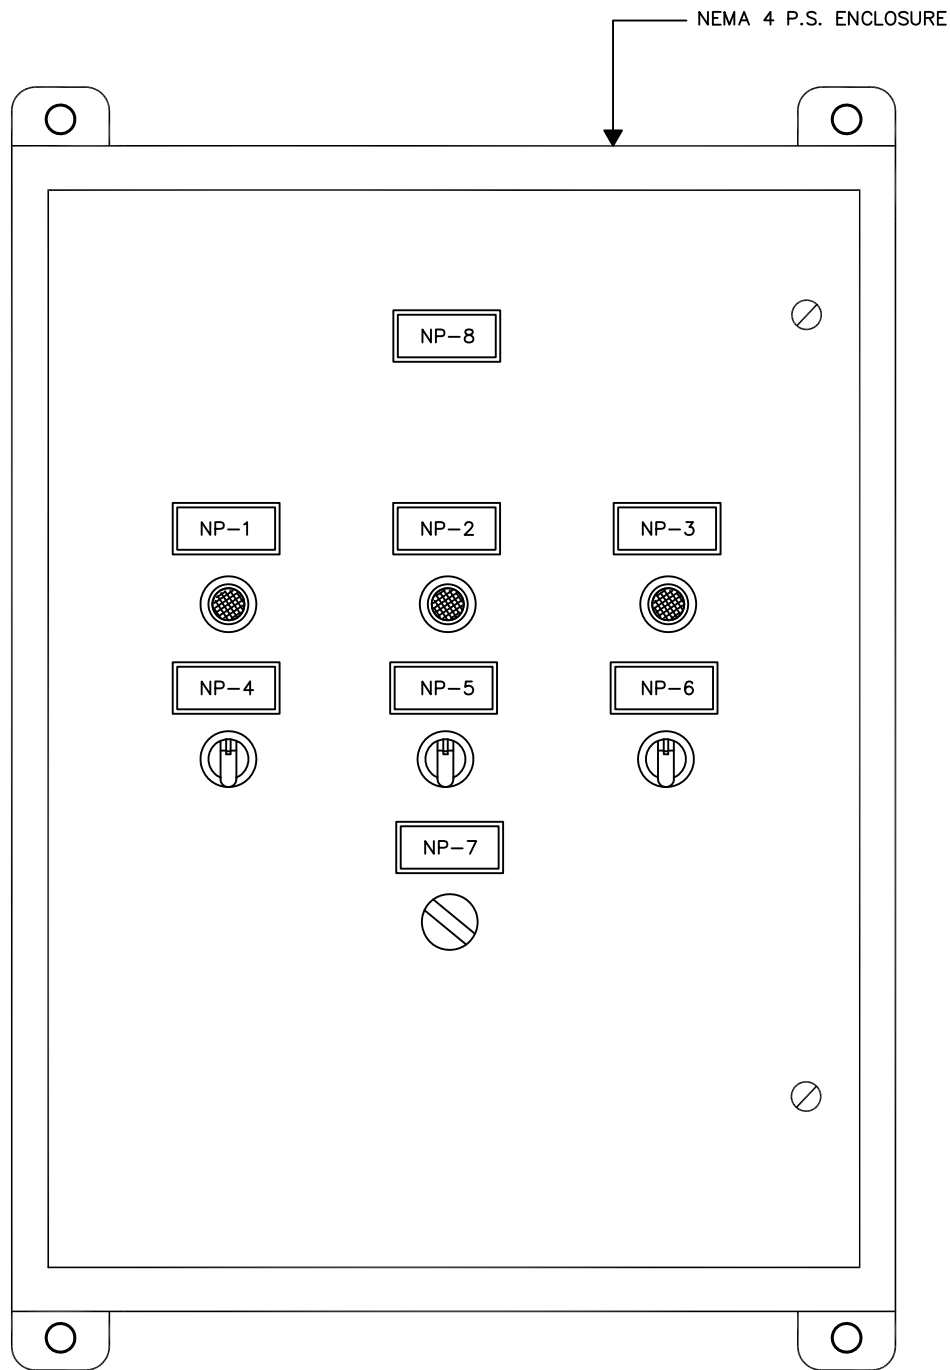

VIEW OF FRONT DOOR OF PANEL

NAMEPLATE SCHEDULE

NP-1	COMPRESSOR 1/RUN
NP-2	COMPRESSOR 2/RUN
NP-3	COMPRESSOR 3/RUN
NP-4	HOA
NP-5	HOA
NP-6	HOA
NP-7	NO. OF COMPRESSOR / 0-1-2-3
NP-8	AD-1

NOTE:
SEWER GASSES WILL DESTROY COMPONENTS IN PANEL.
PROPER SEALS MUST BE INSTALLED EXTERNAL TO THE
PANEL TO PREVENT ENTRY OF GASSES.

Drawing Title									
ENCLOSURE									
DATE	09/21/12	REFERENCE DRAWING	NO.	REVISION-LOCATION	ECN	DATE	BY		
		S/N	Sales Engineer	Application Engineer	DRAWN		APPROVED		
				T.L.	BY E. ECKER		BY	DATE	
Project Title					P.O. Box 77808 Baton Rouge, LA 70879		PURCHASE ORDER NUMBER		
STOLTHAVEN		<div style="text-align: center;"> COX Research and Technology, Inc. </div>			Ph. (225)756-3271 Fax (225)755-1030		DRAWING NUMBER CP-1251r1		
							SHEET NUMBER 4		

BILL OF MATERIALS

ITEM	QTY	MANUFACTURER	PART NO.	DESCRIPTION
1	1	SAGINAW	SCE-30EL2408LP	ENCLOSURE
1a	1	SAGINAW	SCE-30P24	BACKPLATE
2	1	ABB	OT80F3	DISCONNECT SWITCH
3	3	ABB	T1N020TL	CB1,2,3
4	3	ABB	A16-30-10-84	MOTOR STARTER
5	3	ABB	TA25DU14	OL RELAY (10-14A)
6	3	PHOENIX	3048580	FUSE HOLDER
7	1	DIVERSIFIED	ARM-120-ACE	ALTERNATING RELAY
8	1	MARATHON	1323580	DISTRIBUTION BLOCK
9	3	ABB	CL513R	RED LED PILOT
10	3	ABB	C3SS110B-20	HOA SWITCH
11	1	ABB	X4150PSF-1	CPT
12	6	IDEC	RY2SULAC120	CR1-6
13	1	OMRON	H3CR-F8-300	RCT
14	1	SIEMENS	52SX2HAB	4 POSITION SWITCH
15	2	SIEMENS	52BAK	CONTACT BLOCKS
16	2	SIEMENS	52BAJ	CONTACT BLOCKS
17				
18				
19				
20				
21				
22				
23				
24				

	Drawing Title						
	<h2 style="margin: 0;">BILL OF MATERIALS</h2>						
DATE 09/21/12		REFERENCE DRAWING S/N	NO. Sales Engineer	REVISION-LOCATION Application Engineer T.L.	ECN	DATE	BY
	Project Title	<div style="border: 1px solid black; padding: 5px; margin: 0 auto; width: 150px;"> <h3 style="margin: 0;">COX</h3> <p style="margin: 0; font-size: small;">Research and Technology, Inc.</p> </div>			<div style="border: 1px solid black; padding: 5px; margin: 0 auto; width: 150px;"> <p style="margin: 0; font-size: small;">P.O. Box 77808 Baton Rouge, LA 70879</p> <p style="margin: 0; font-size: small;">Ph. (225)756-3271 Fax (225)755-1030</p> </div>		<div style="border: 1px solid black; padding: 5px; margin: 0 auto; width: 150px;"> <p style="margin: 0; font-size: small;">PURCHASE ORDER NUMBER</p> <p style="margin: 0; font-size: small;">DRAWING NUMBER CP-1251r1</p> <p style="margin: 0; font-size: small;">SHEET NUMBER</p> </div>
	<h2 style="margin: 0;">STOLTHAVEN</h2>	<div style="display: flex; justify-content: space-between; font-size: x-small;"> 5 </div>					