
COX


Research and Technology, Inc.

PANEL LP1
LIGHTING
CONTROL PANEL


AS BUILTS

SEPTEMBER 28, 2012


Cox Research and Technology, Inc.
14697 S. Harrells Ferry Road
Baton Rouge, LA. 70816
(225) 756-3271 Fax (225) 755-1030

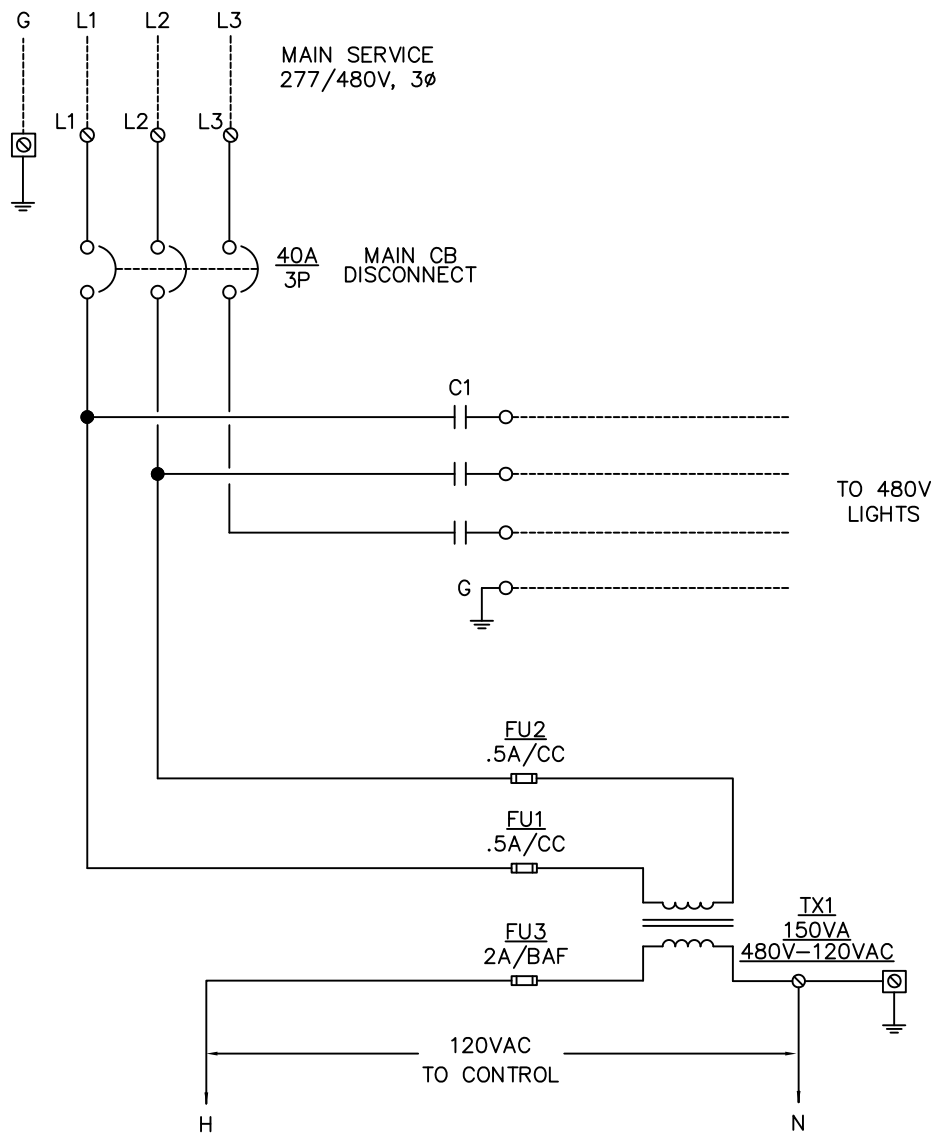

	Drawing Title							
	POWER DIAGRAM							
DATE		REFERENCE DRAWING	NO.	REVISION-LOCATION	ECN	DATE	BY	
09/21/12		S/N	Sales Engineer	Application Engineer	BY	E. ECKER	APPROVED	
	Project Title			T.L.			BY	DATE
	STOLTHAVEN						PURCHASE ORDER NUMBER	
							DRAWING NUMBER	
							CP-1249r1	
							SHEET NUMBER	
								2

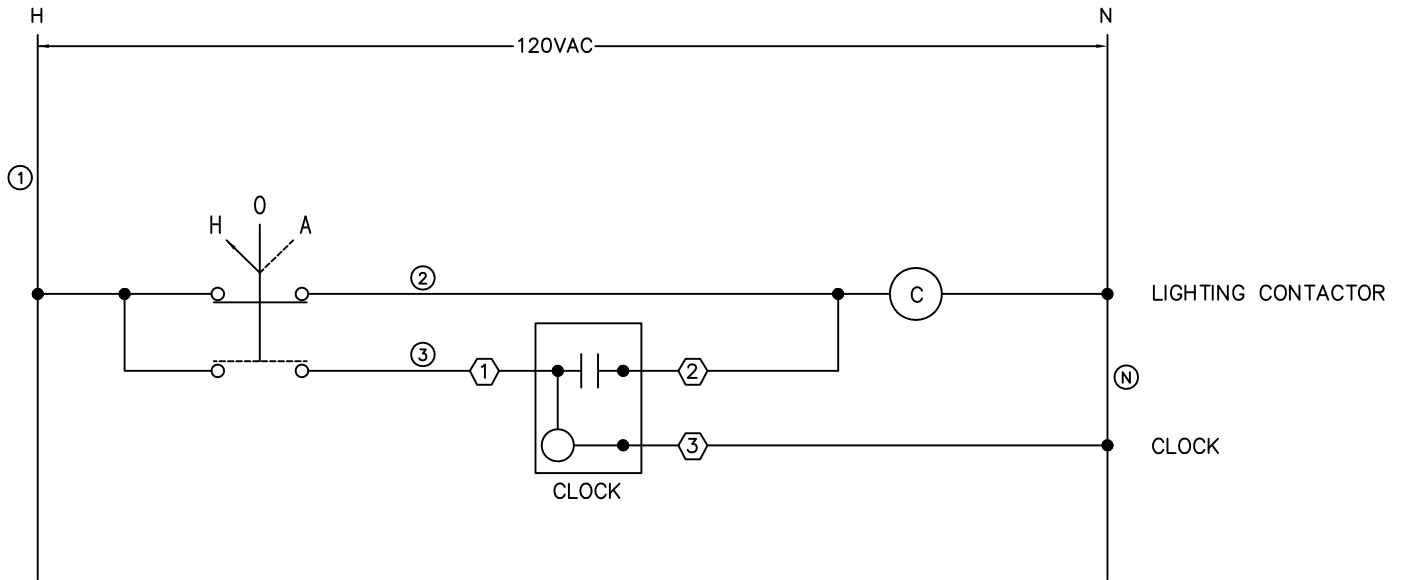

	Drawing Title CONTROL DIAGRAM							
DATE 09/21/12		REFERENCE DRAWING S/N	NO. Sales Engineer	REVISION-LOCATION Application Engineer T.L.	ECN	DATE	BY	
	Project Title				DRAWN BY E. ECKER		APPROVED BY	
	STOLTHAVEN	<div>COX</div> <div>Research and Technology, Inc.</div>			P.O. Box 77808 Baton Rouge, LA 70879 Ph. (225)756-3271 Fax (225)755-1030		PURCHASE ORDER NUMBER	
							DRAWING NUMBER CP-1249r1	
							SHEET NUMBER 3	

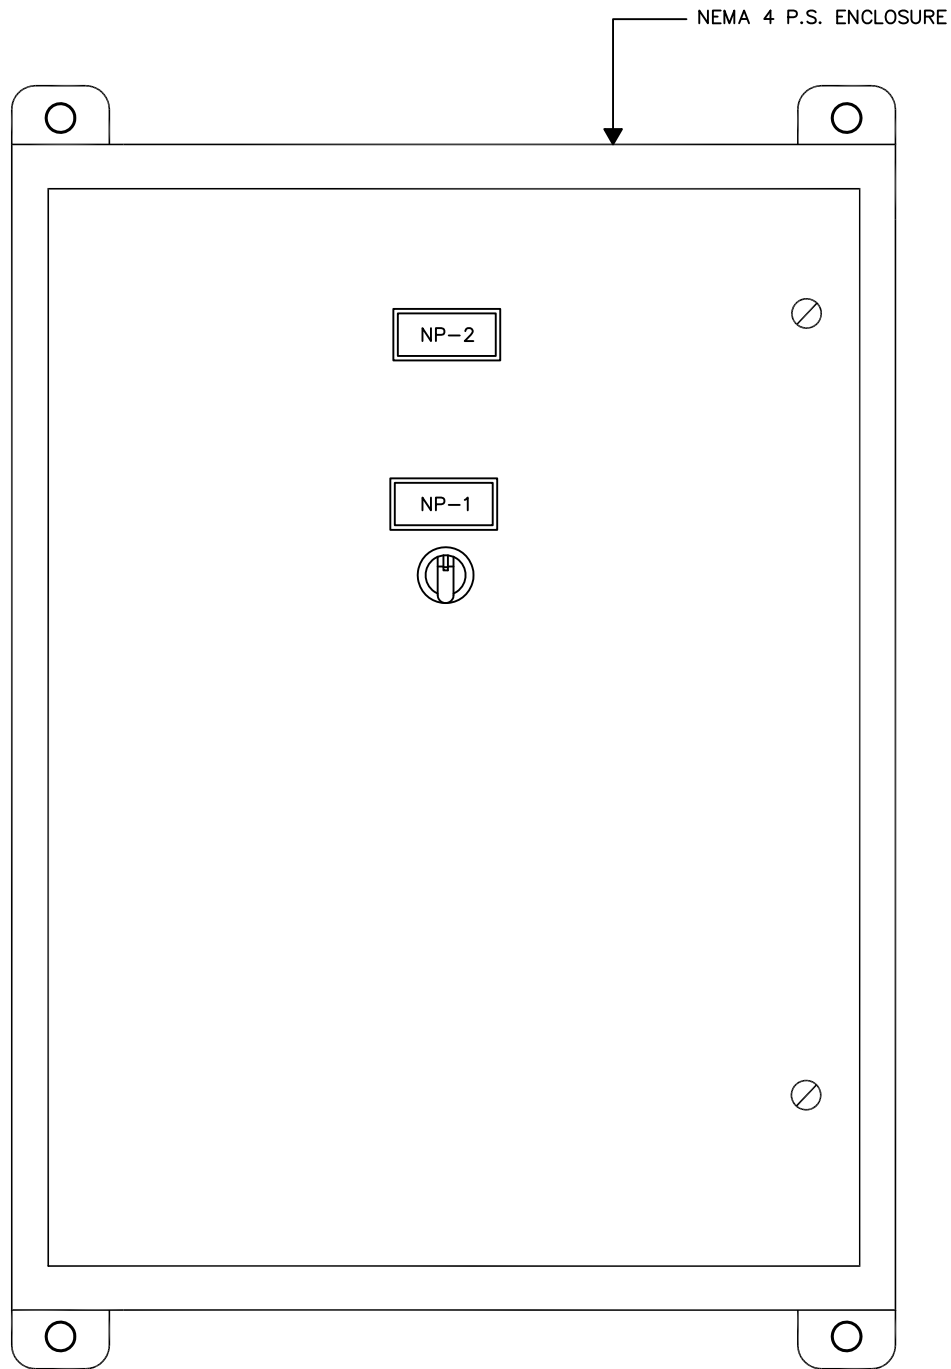

VIEW OF FRONT DOOR OF PANEL

NAMEPLATE SCHEDULE

NP-1 HOA
NP-2 LIGHTING CONTACTOR
PANEL LP1

NOTE:
SEWER GASSES WILL DESTROY COMPONENTS IN PANEL.
PROPER SEALS MUST BE INSTALLED EXTERNAL TO THE
PANEL TO PREVENT ENTRY OF GASSES.

	Drawing Title						
	ENCLOSURE						
DATE		REFERENCE DRAWING	NO.	REVISION-LOCATION	ECN	DATE	BY
09/21/12		S/N	Sales Engineer	Application Engineer			
	Project Title			T.L.	BY E. ECKER	BY	DATE
	STOLTHAVEN	<div style="text-align: center;"> COX Research and Technology, Inc. </div>			P.O. Box 77808 Baton Rouge, LA 70879 Ph. (225)756-3271 Fax (225)755-1030	PURCHASE ORDER NUMBER DRAWING NUMBER CP-1249r1 SHEET NUMBER 4	

BILL OF MATERIALS

ITEM	QTY	MANUFACTURER	PART NO.	DESCRIPTION
1	1	SAGINAW	SCE-16EL1408LP	ENCLOSURE
1a	1	SAGINAW	SCE-16P14	BACKPLATE
2	1	ABB	T1N040TL	CB1
3	1	ABB	A50-30-11-84	CONTACTOR
4	1	ABB	X4150PSF-1	CPT
5	1	ABB	C3SS110B-20	HOA SWITCH
6	1	GRASSLIN	FM1/STUZZ	CLOCK
7				
8				
	Drawing Title						
	<h2 style="margin: 0;">BILL OF MATERIALS</h2>						
DATE		REFERENCE DRAWING	NO.	REVISION-LOCATION	ECN	DATE	BY
09/21/12		S/N	Sales Engineer	Application Engineer	DRAWN		APPROVED
	Project Title	T.L.			BY E. ECKER		DATE
	<h2 style="margin: 0;">STOLTHAVEN</h2>	<div style="border-top: 3px double black; border-bottom: 3px double black; padding: 5px 0;"> <h1 style="margin: 0;">COX</h1> </div>			P.O. Box 77808 Baton Rouge, LA 70879 Ph. (225)756-3271 Fax (225)755-1030		PURCHASE ORDER NUMBER
		Research and Technology, Inc.					DRAWING NUMBER CP-1249r1