

---

---

COX

Research and Technology, Inc.

---

---

DUPLEX PUMP  
CONTROL PANEL  
THE WOODLANDS  
CITY OF RUSTON

AS BUILTS

---

Cox Research and Technology, Inc.  
14697 S. Harrells Ferry Road  
Baton Rouge, LA. 70816  
(225) 756-3271 Fax (225) 755-1030

CP-2294

VOLTAGE	120/240V	(480V, 277/480V, 240V, 120/240V, 208V, 120/208V)
PHASE/HZ	1/60	
NO. MOTORS	2	
HP	2	
FLA	15	
TYPE OF PUMP	Submersible	(Self-Priming, Submersible)
MANUFACTURER	BARNES	
CATALOG NUMBER	SGVF2022L-MS	
CONTROL VOLTAGE	120V	(120V, Other)
ENCLOSURE	NEMA 4X	(NEMA 1, NEMA 3R, NEMA 4, NEMA 4X)
ENCLOSURE MATERIAL	Fiberglass	(Painted Steel, Stainless Steel, Fiberglass)
CONTROL SENSOR	Floats	(Floats, Bubbler, Other)
CAPACITORS	YES	(Yes, No)
CAPACITOR WIRING FIGURE	N/A	
THERM. & SEAL FAIL WIRING FIGURE		


OPTIONS:

SEAL FAIL LIGHTS	X	(Submersible Only)
SEAL FAIL RELAYS		(Submersible Only)
SEAL FAIL PUMP SHUTDOWN		(Submersible Only)
HT PUMP SHUTDOWN		(Self-Primer, Submersible)
ALARM HORN		
ALARM LIGHT	X	
LIGHT PANEL MTD	X	
LIGHT REMOTE MTD		
LIGHT FLASHER		
LIGHTNING ARRESTER	X	
ELAPSED TIME METER	X	
PHASE MONITOR		
NEMA RATED STARTERS		
GROUND FAULT RECPT.	X	
GREEN RUN LIGHTS VS. RED		
POLE, BOX, SEAL		
INTRINSICALLY SAFE RELAYS		
HIGH TEMP. LOCKOUT, MANUAL RESET		
ECONOMY VERSION		


SOLD TO: Delta Process - Bossier City, LA  
TAG : South Bossier Travel Plaza

SHIP TO: Delta Process - Ruston, LA

	Drawing Title							
	PANEL DESCRIPTION							
DATE 1/25/06			REFERENCE DRAWING S/N	NO. Sales Engineer C.C.	REVISION-LOCATION Application Engineer R.C.	DRAWN BY C. RACHAL	ECN	DATE
	Project Title		<div style="text-align: center;"> <b>COX</b>  Research and Technology, Inc. </div>			P.O. Box 77808 Baton Rouge, LA 70809  Ph. (225)756-3271 Fax (225)755-1030		PURCHASE ORDER NUMBER  DRAWING NUMBER CP-2294 SHEET NUMBER 1
	DUPLIX PUMP CONTROL PANEL							

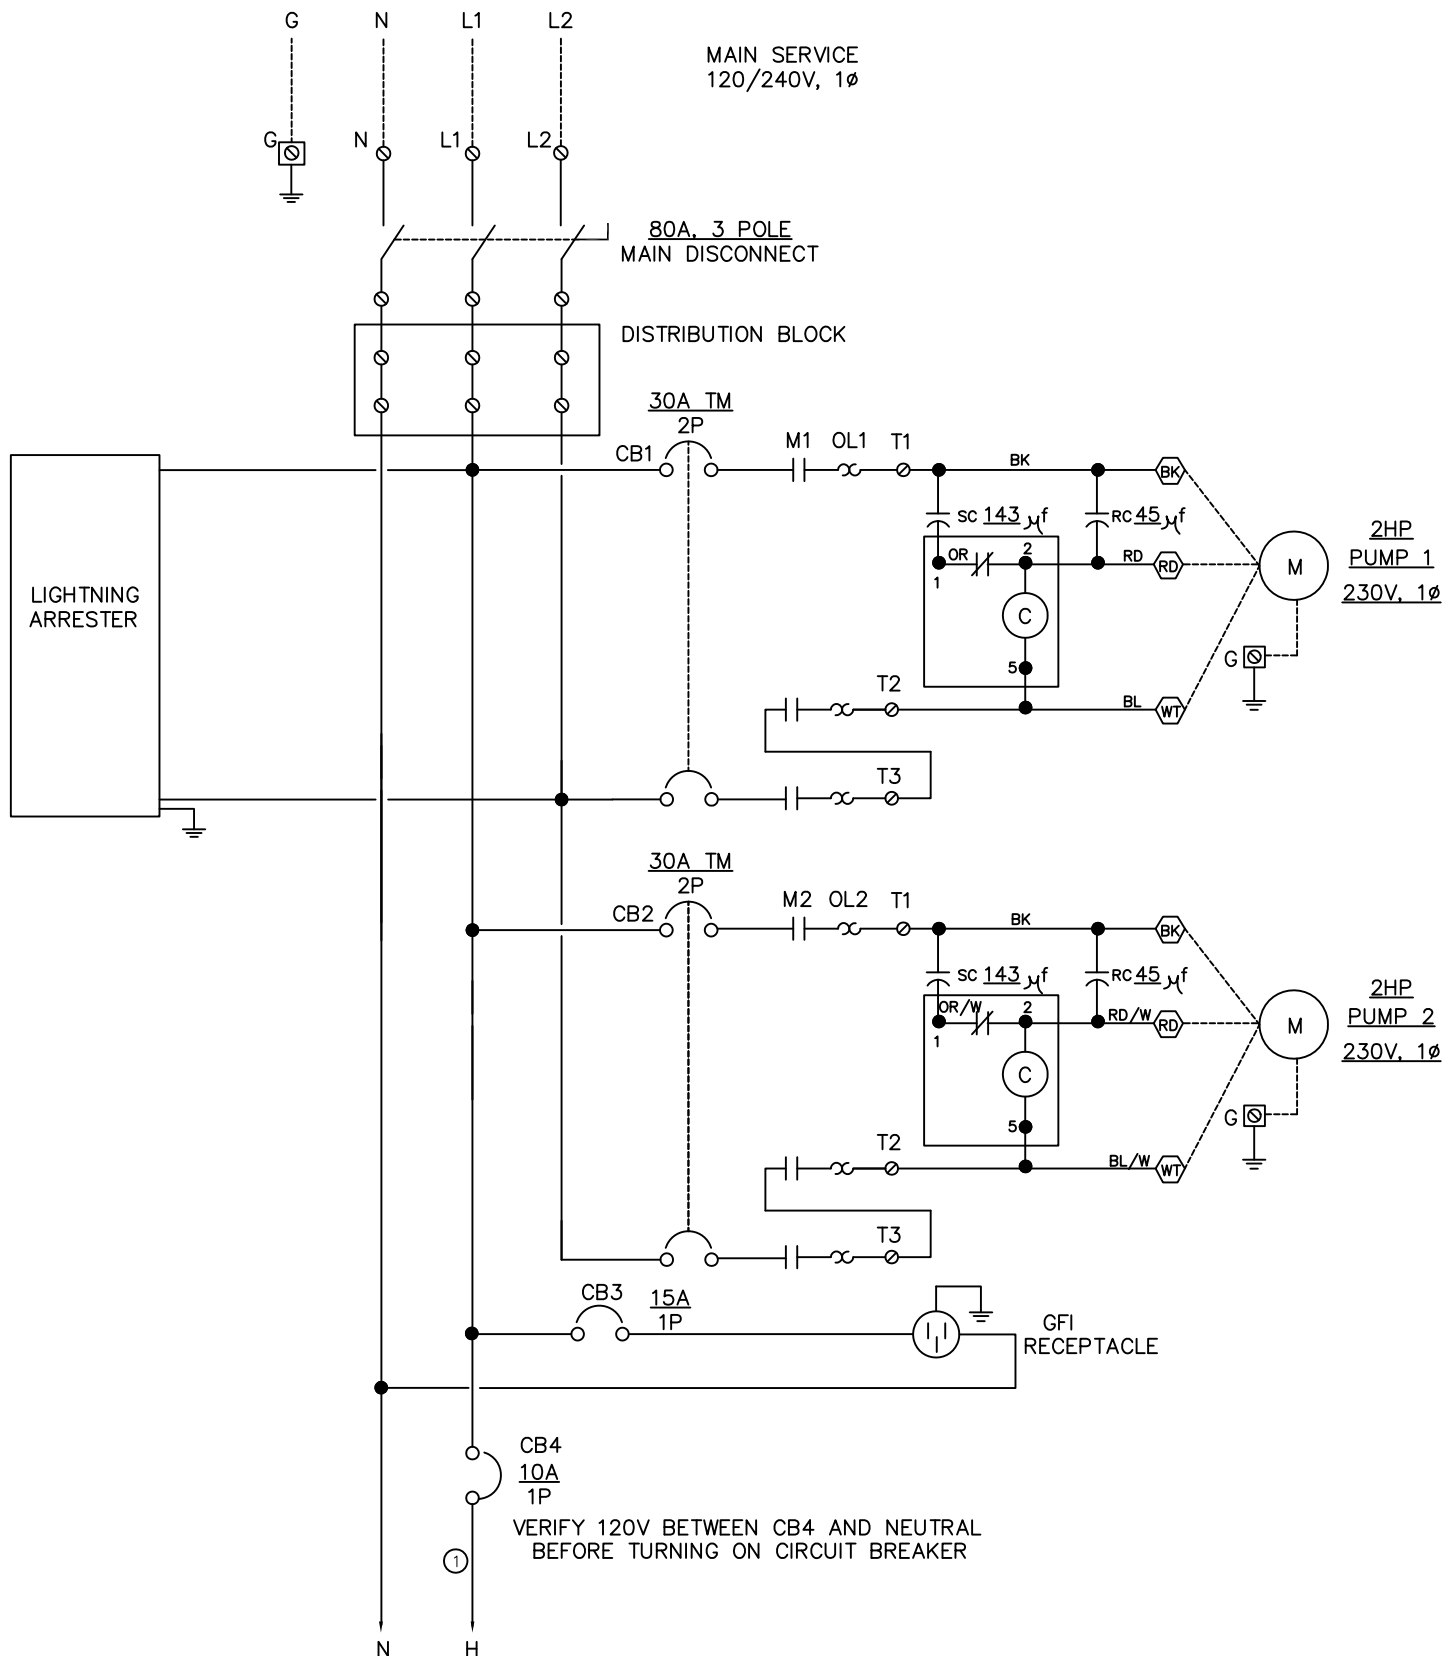

Drawing Title							
POWER DIAGRAM							
DATE 1/25/06		REFERENCE DRAWING		NO.		REVISION-LOCATION	
		S/N		Sales Engineer C.C.		Application Engineer R.C.	
Project Title				DRAWN BY C. RACHAL		APPROVED BY	
DUPLIX PUMP CONTROL PANEL				P.O. Box 77808 Baton Rouge, LA 70809		PURCHASE ORDER NUMBER	
				Ph. (225)756-3271 Fax (225)755-1030		DRAWING NUMBER CP-2294	
						SHEET NUMBER 2	

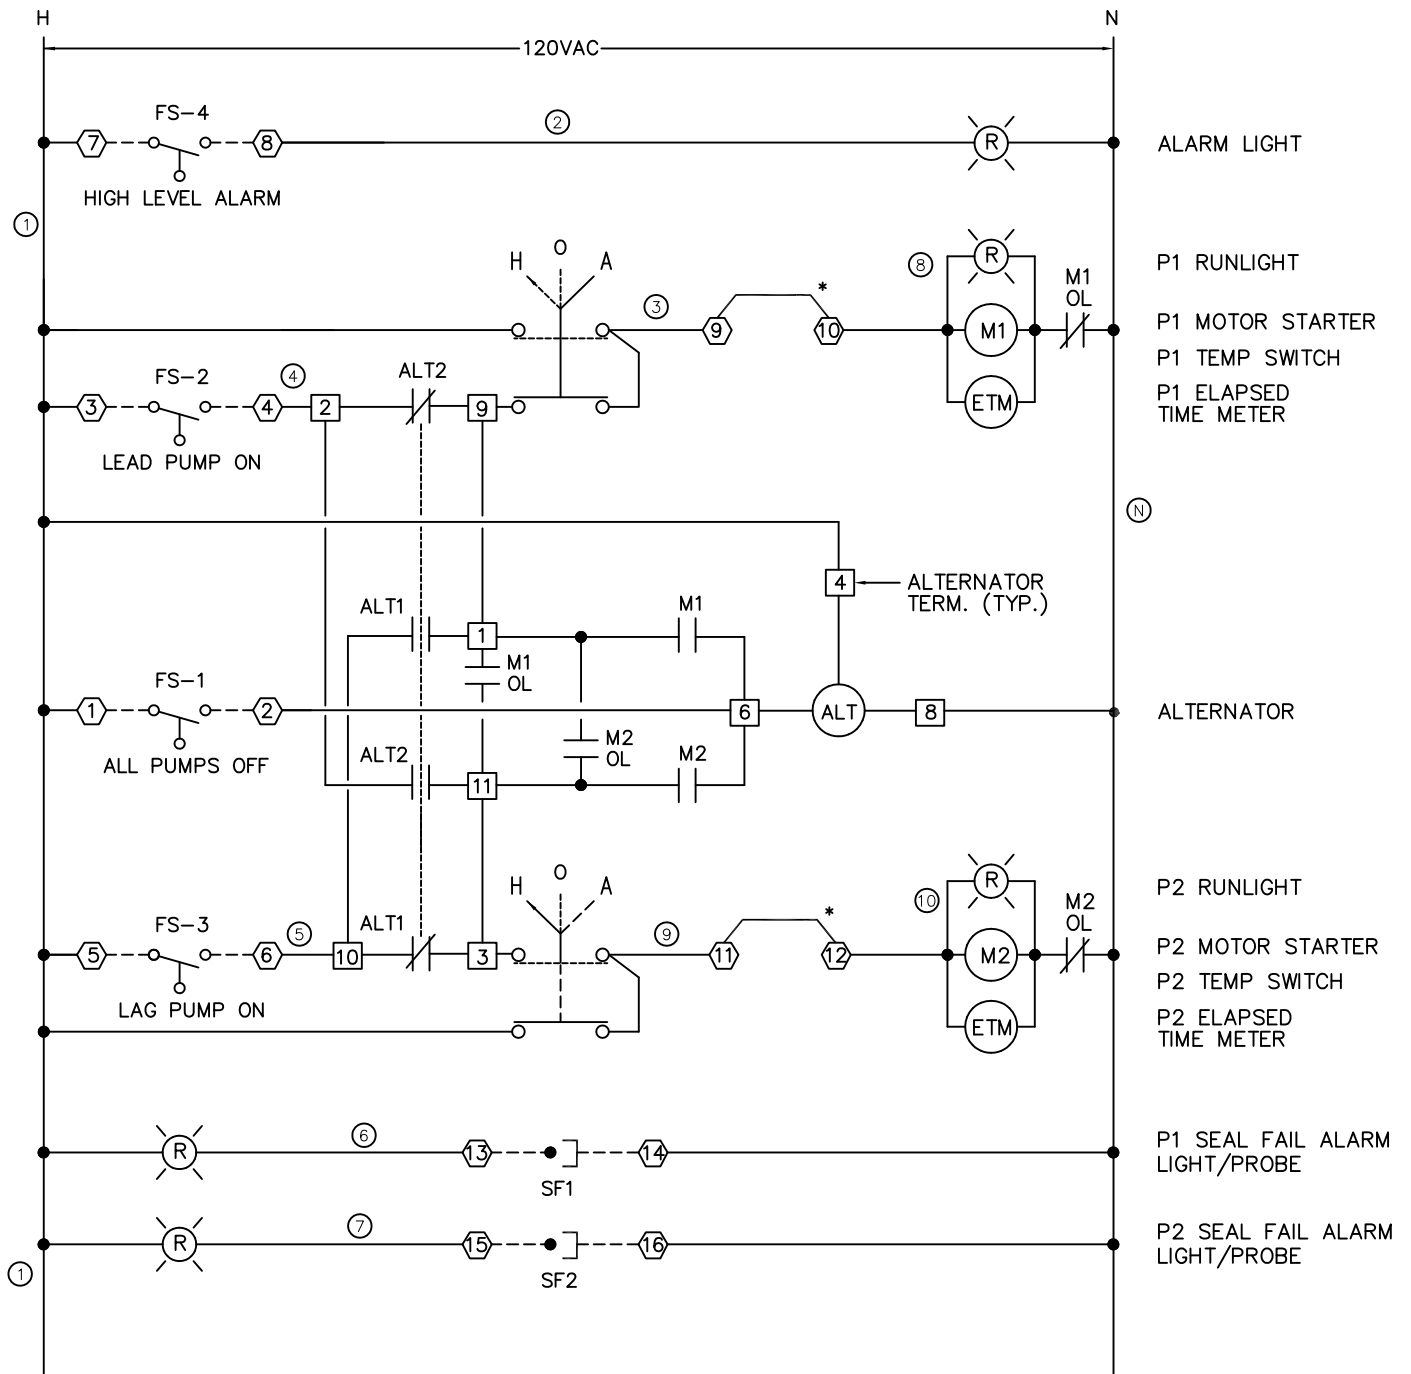

\* REMOVE JUMPERS AND INSTALL LOCKOUT DEVICES IF REQUIRED.

Drawing Title									
CONTROL DIAGRAM									
DATE		REFERENCE DRAWING		NO.		REVISION-LOCATION		ECN	
1/25/06		S/N		Sales Engineer		Application Engineer		DRAWN	
				C.C.		R.C.		BY C. RACHAL	
Project Title								APPROVED	
DUPLIX PUMP CONTROL PANEL								BY	
								DATE	
								PURCHASE ORDER NUMBER	
								DRAWING NUMBER	
								CP-2294	
								SHEET NUMBER	
								3	



## BILL OF MATERIALS

ITEM	QTY	MANUFACTURER	PART NO.	DESCRIPTION
1	1	STAHLIN	RJ1816HPLDF	ENCLOSURE
1a	1	STAHLIN	BP1816AL	BACKPLATE
2	1	ABB	OT63E3	MAIN DISC. SWITCH
3	2	ABB	A16-30-10-84	MOTOR STARTER
4	2	ABB	TA25DU19	O.L. (13-19A)
5	2	SQUARE D	QOU230	CB1, CB2
6	1	SQUARE D	QOU115	CB3
7	1	TIMEMARK	261DT120	ALTERNATING RELAY
8	4	ACI	JR22FR	RED PILOT LIGHT
9	2	ACI	JR22P3M20B	HOA SWITCH
10	1	AC/DC	BL5-R-120	ALARM LIGHT
11	1	MARATHON	1323580	DISTRIBUTION BLOCK
12	2	REDINGTON	711-0190	ELAPSED TIME METER
13	1	SQUARE D	QOU110	CB4
14	1	DELTA	LA302	LIGHTNING ARRESTER
15	1	STOCK		GFI
16	2	MALLORY	4CU54	143 $\mu$ f CAPACITOR
17	2	GE	5X434	45 $\mu$ f CAPACITOR
18	2	GE	6X559	START RELAY
19				
20				
21				
22				
23				
24				
25				

	Drawing Title						
	BILL OF MATERIALS						
DATE 1/25/06		REFERENCE DRAWING S/N	NO. Sales Engineer C.C.	REVISION-LOCATION Application Engineer R.C.	DRAWN BY C. RACHAL	ECN	DATE
	Project Title	<div style="border: 1px solid black; padding: 5px; margin: 0 auto; width: 150px;"> <b>COX</b>  <small>Research and Technology, Inc.</small> </div>			P.O. Box 77808 Baton Rouge, LA 70809  Ph. (225)756-3271 Fax (225)755-1030		PURCHASE ORDER NUMBER  DRAWING NUMBER CP-2294 SHEET NUMBER 5
	DUPLEX PUMP CONTROL PANEL						