






CP1818-6-1HP  
FOR  
CP12240-1-6-1HP

AS BUILTS  
OCTOBER 14, 2019

---

Delta Treatment Systems  
9125 Comar Drive  
Walker, LA 70785  
(225) 665-6162 Fax (800) 219-9183

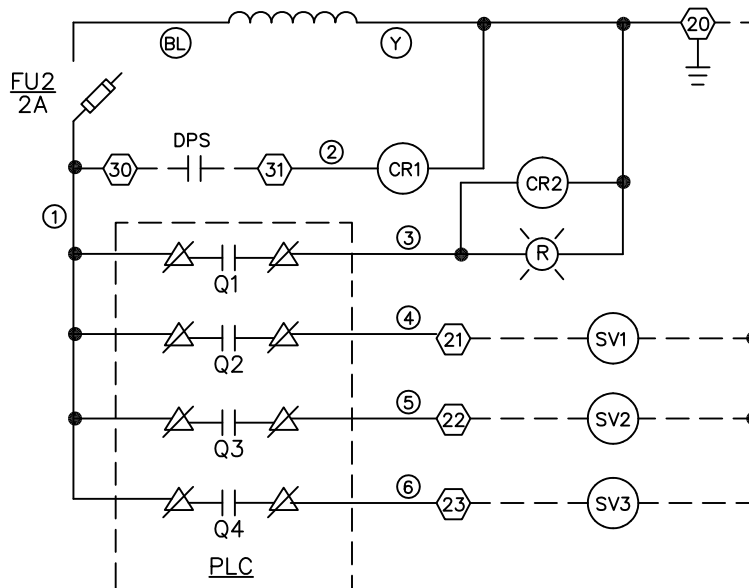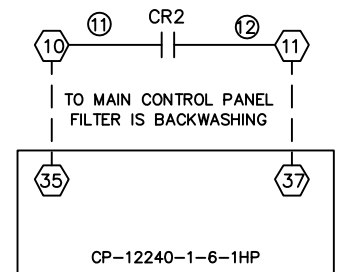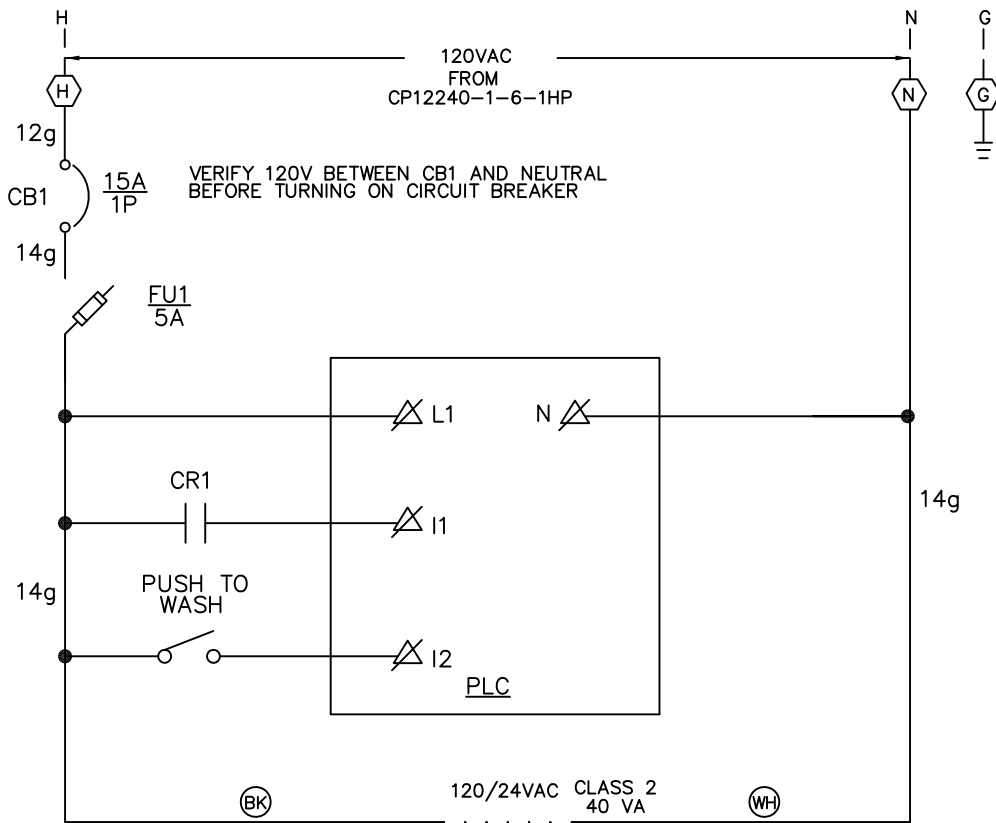

FILTER BACKWASHING LIGHT

MAIN VALVE

FILTER 1 VALVE

FILTER 2 VALVE

ON FILTER RACK

Program Name: NET2r4



Delta Treatment Systems  
9125 Comar Drive Walker, LA 70782

# SCHEMATIC DIAGRAM DUAL DISC. FILTER BACKWASH CONTROL PANEL



DWN BY:  
BMF

DATE:  
10/14/19

SCALE:  
N.T.S.

DWG. NO. :  
-

JOB NO. :  
CP1818-6-1HP

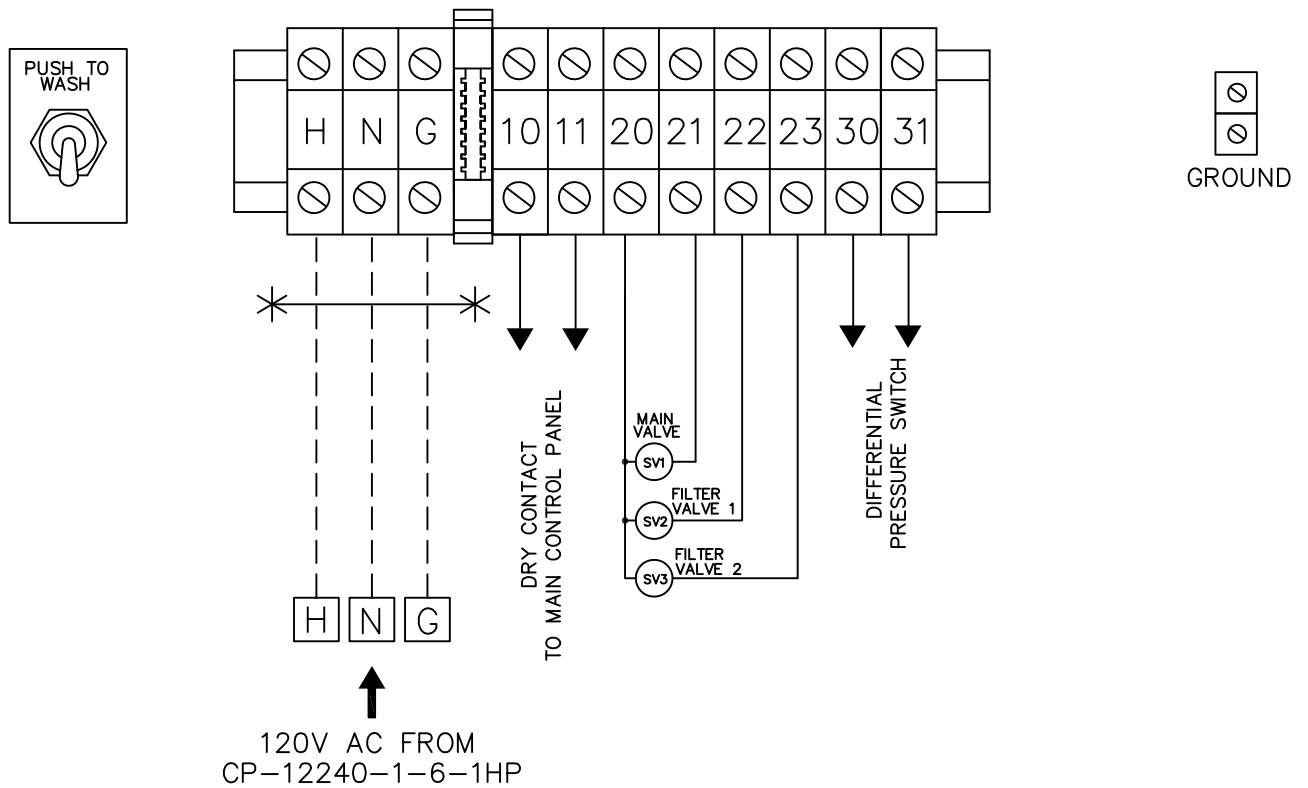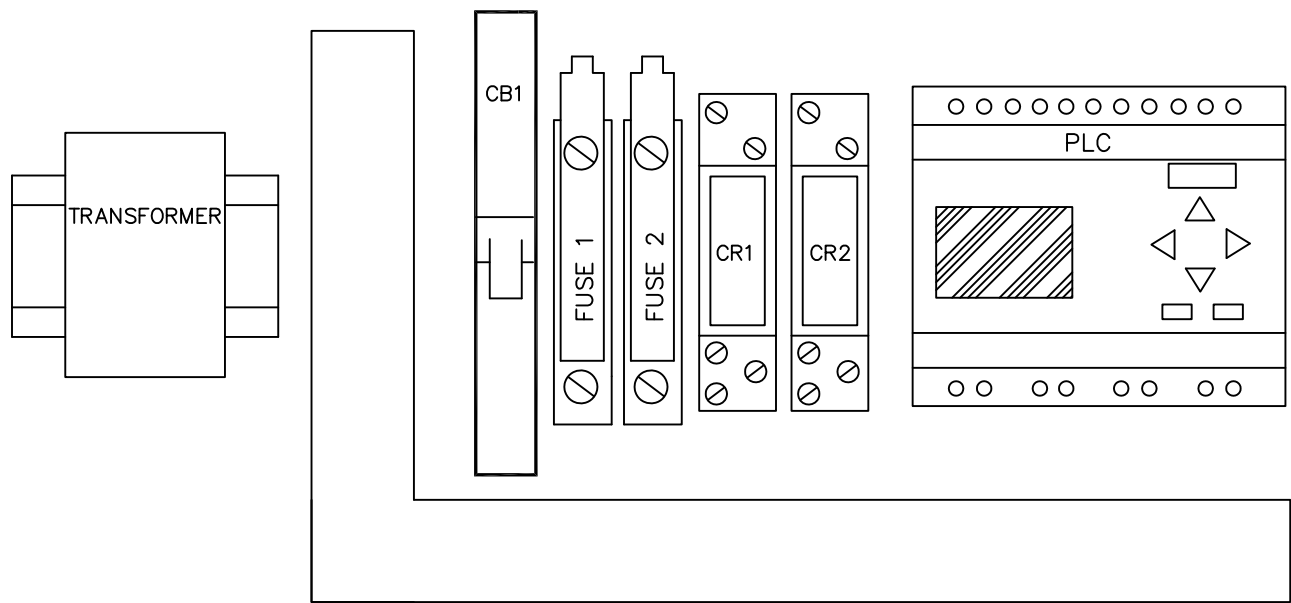

Delta Treatment Systems  
9125 Comar Drive Walker, LA 70782

## EXTERNAL CONNECTIONS DUAL DISC. FILTER BACKWASH CONTROL PANEL


DWN BY:  
BMF

DATE:  
10/14/19

SCALE:  
N.T.S.

DWG. NO. :  
—

JOB NO. :  
CP1818-6-1HP

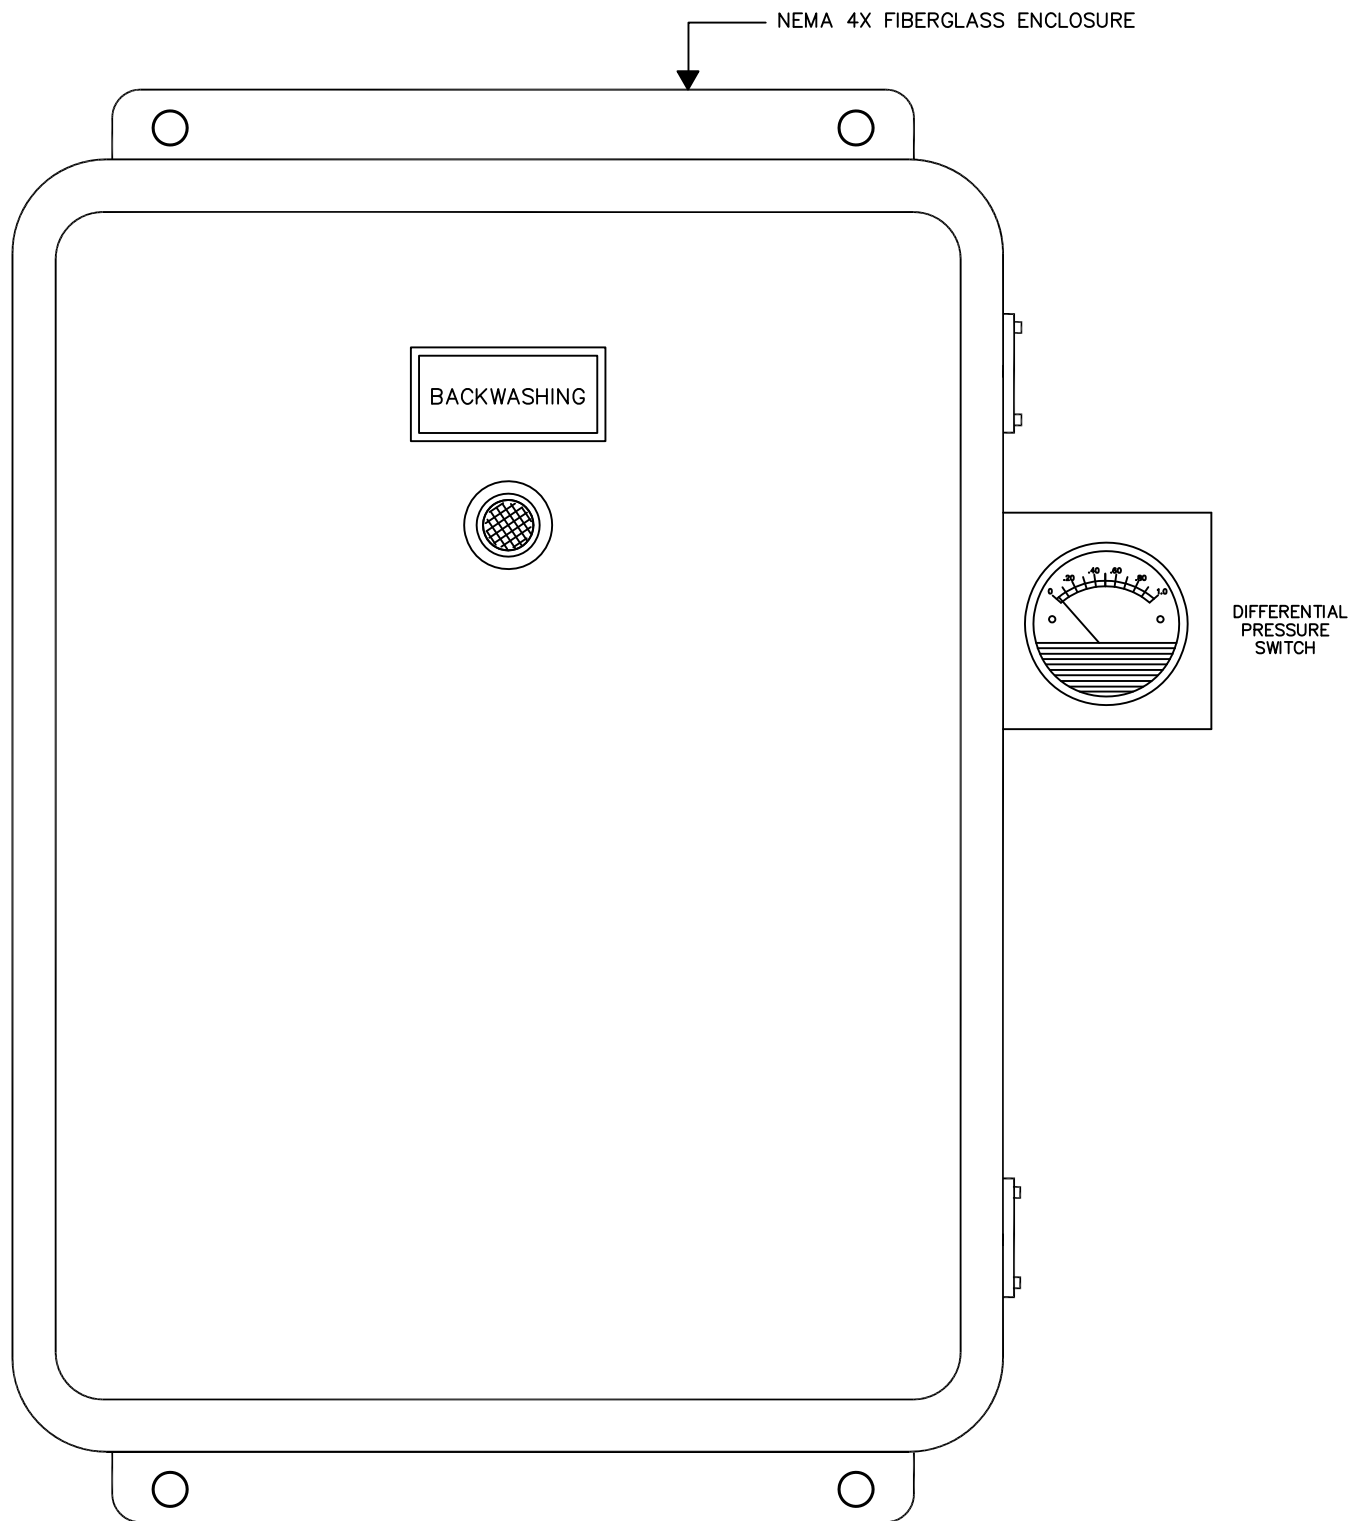

VIEW OF FRONT OF PANEL

**NOTE:**  
SEWER GASSES WILL DESTROY COMPONENTS IN PANEL.  
PROPER SEALS MUST BE INSTALLED EXTERNAL TO THE  
PANEL TO PREVENT ENTRY OF GASSES.



Delta Treatment Systems  
9125 Comar Drive Walker, LA 70782

ENCLOSURE  
DUAL DISC. FILTER  
BACKWASH CONTROL PANEL

DWN BY:  
BMF

DATE:  
10/14/19

SCALE:  
N.T.S.

DWG. NO. :  
—

JOB NO. :  
CP1818-6-1HP

## BILL OF MATERIAL

ITEM	QTY	MANUFACTURER	PART NO.	DESCRIPTION
1	1	STAHLIN	FEDWG1614	ENCLOSURE
2	1	SQUARE D	QOU115	CB1
3	2	PHOENIX	UT4 HESI	FUSE 1,2
4	2	IDEC	RY2SULAC24	24V RELAY 1,2
5	1	SEIMENS	OBA6	PLC
6	1	WHITE RODGERS	90T40F3	120V/24V TRANSFORMER
7	1	STOCK	EZ SWITCH	SWITCH
8	1	MURPHY	A20DP-K-15	DIFF PRESSURE SWITCH
9	1	EBT	511-1548	24VAC LED LIGHT
10	1	ABB	CL100-R	LED LIGHT HOLDER
11				
12				
13				
14				
15				
16				
17				



Delta Treatment Systems  
9125 Comar Drive Walker, LA 70782

### BILL OF MATERIALS DUAL DISC. FILTER BACKWASH CONTROL PANEL


DWN BY:  
BMF

DATE:  
10/14/19

SCALE:  
N.T.S.

DWG. NO. :  
—

JOB NO. :  
CP1818-6-1HP

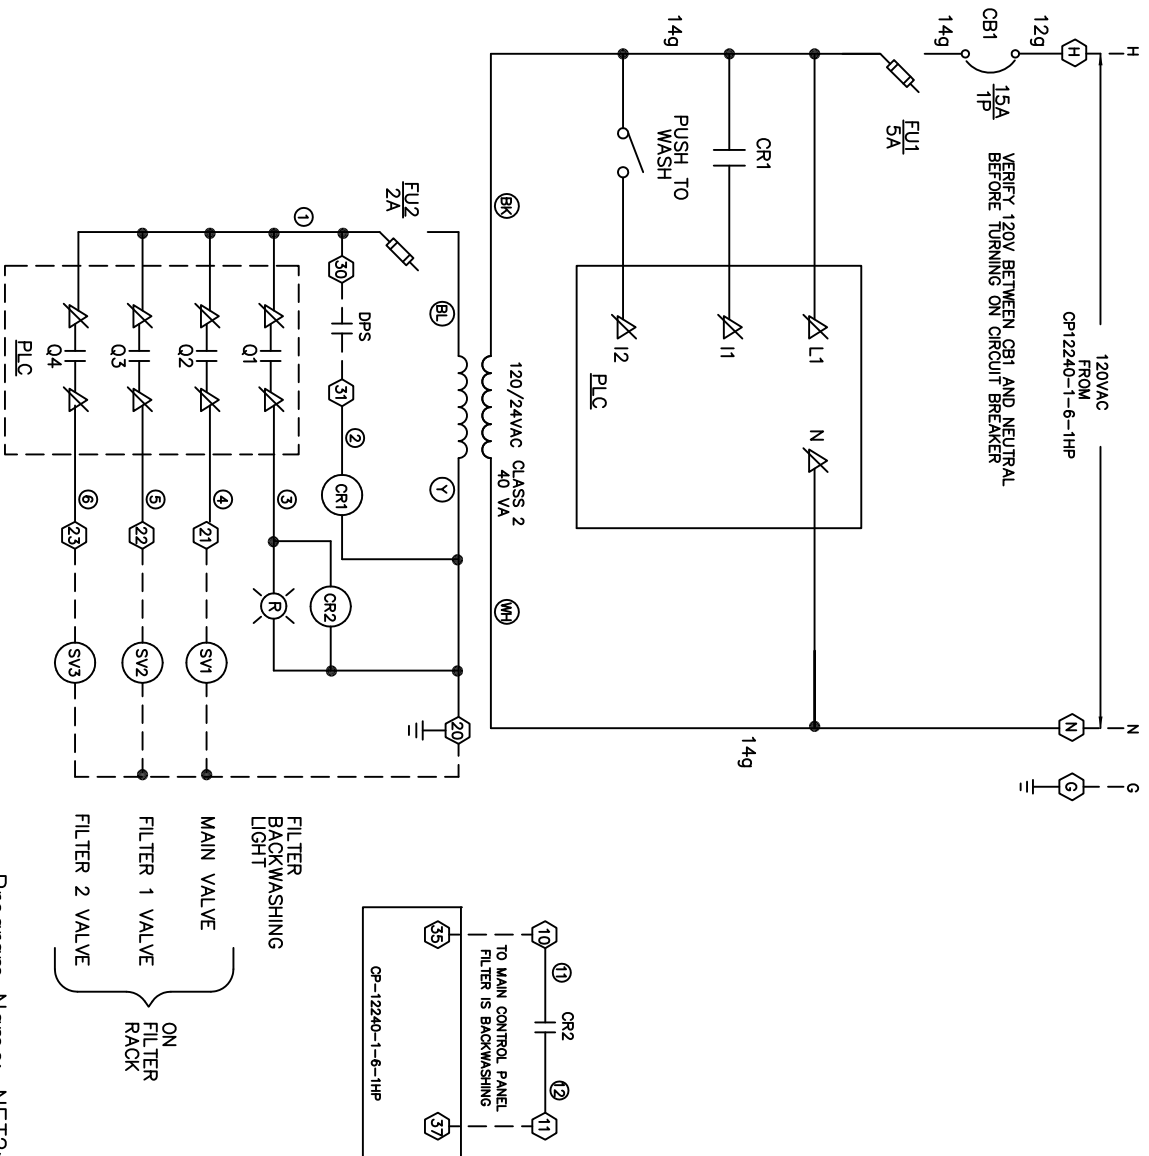

Program Name: NET2r4

Delta Treatment Systems  
9125 Comar Drive  
Walker, LA 70785  
(225) 665-6162 Fax (800) 219-9183  
CP1818-6-1HP