

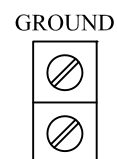
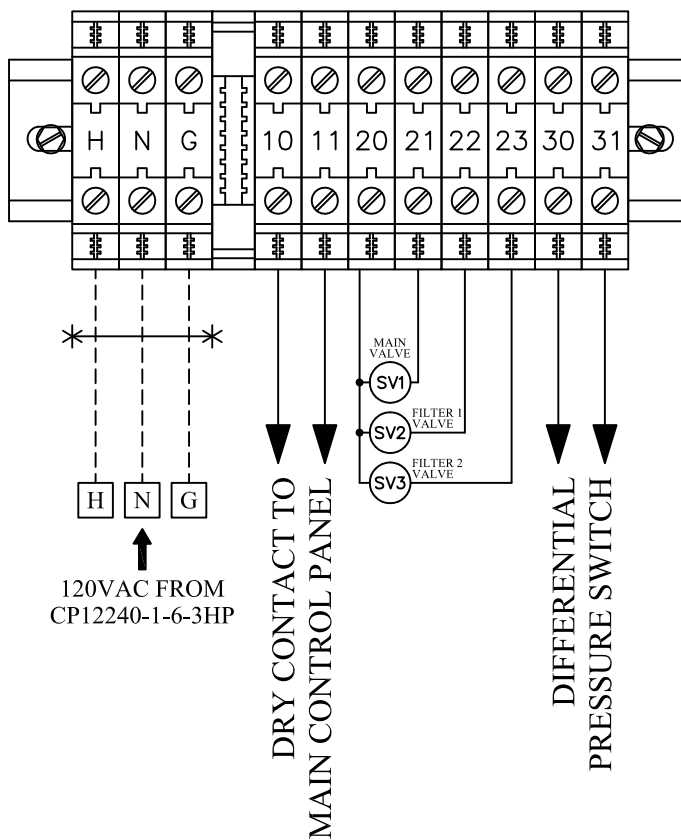


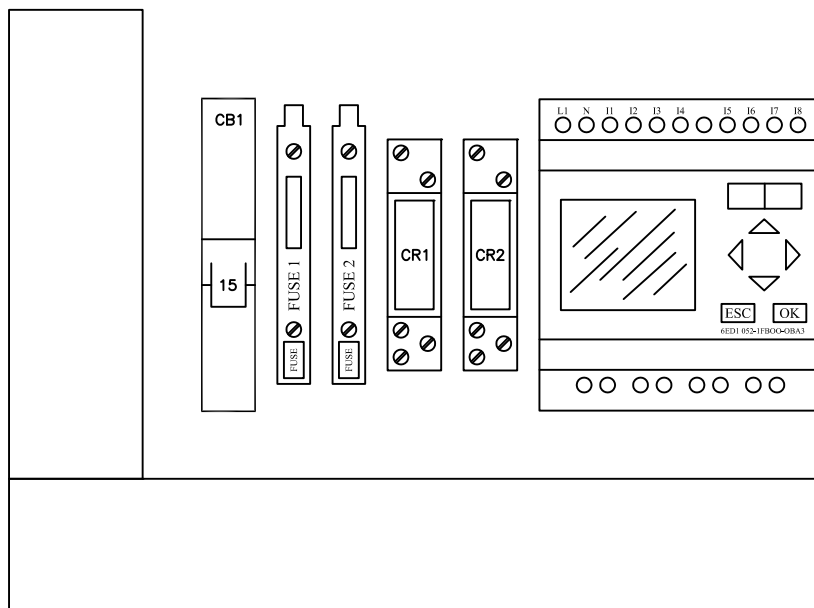

LESTERVILLE
CP-1818 FOR
CP12240-1-6-3HP

AS BUILTS
JULY 5, 2018

Delta Treatment Systems
9125 Comar Drive
Walker, LA 70785
(225) 665-6162 Fax (800) 219-9183

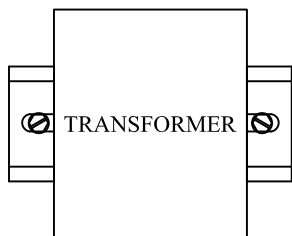

Delta Treatment Systems
9125 Comar Drive Walker, LA 70782

EXTERNAL CONNECTIONS DUAL DISC. FILTER BACKWASH CONTROL PANEL


DWN BY:
BMF

DATE:
07/05/18

SCALE:
N.T.S.

DWG. NO. :
2/3

JOB NO. :
CP-1818

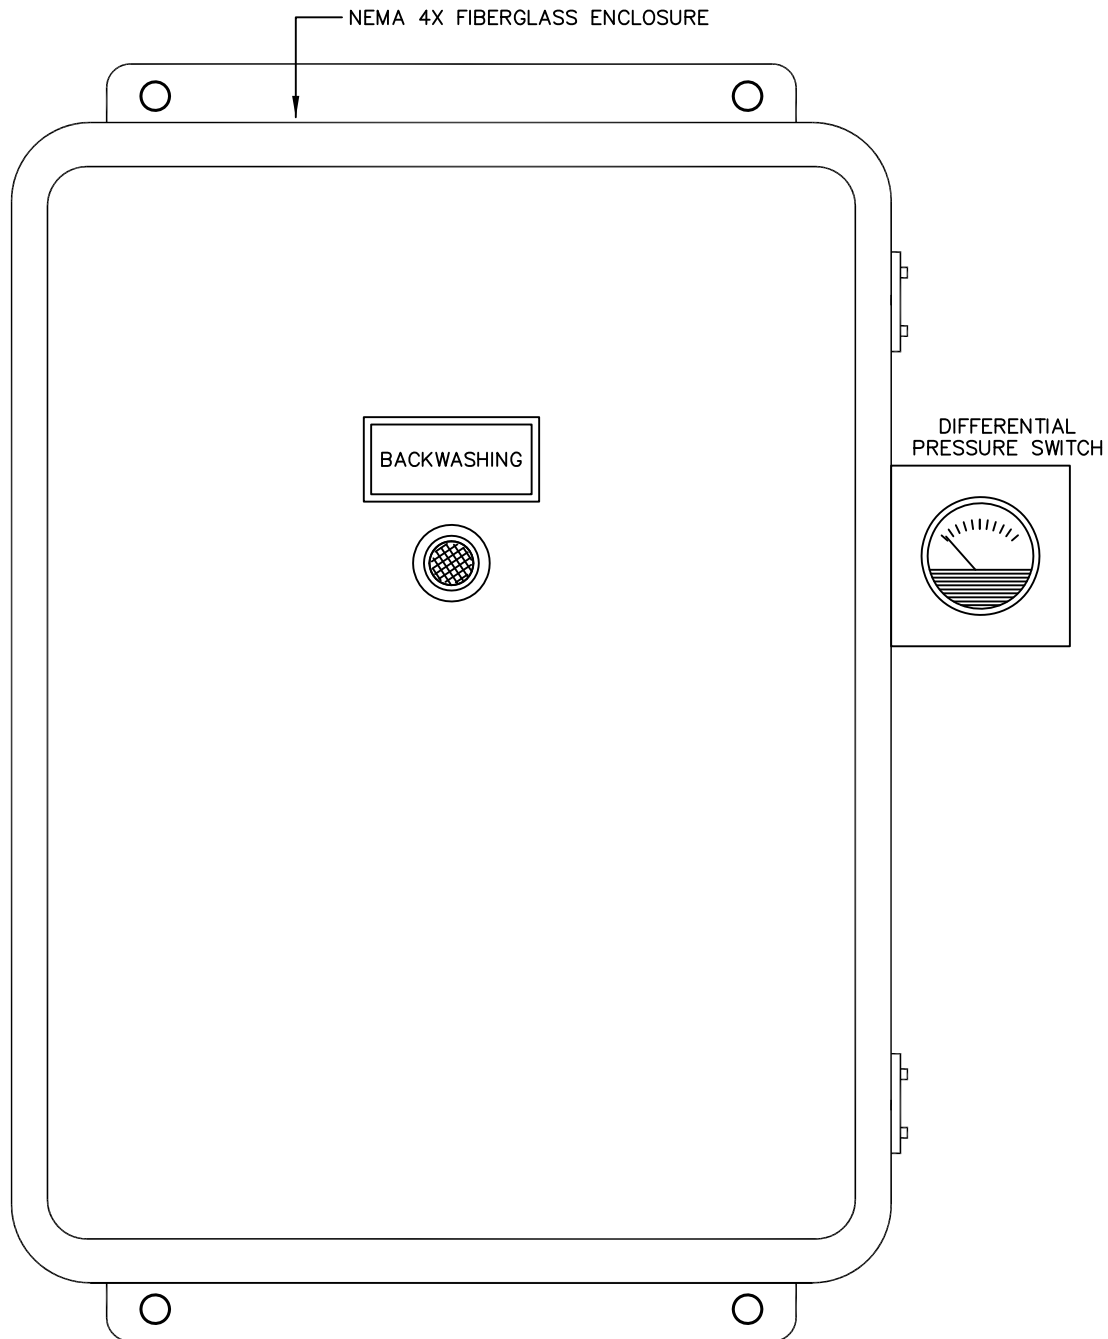

VIEW OF FRONT OF PANEL

NOTE:

SEWER GASSES WILL DESTROY COMPONENTS IN PANEL.
PROPER SEALS MUST BE INSTALLED EXTERNAL TO THE
PANEL TO PREVENT ENTRY OF GASSES.



Delta Treatment Systems
9125 Comar Drive Walker, LA 70782

ENCLOSURE
DUAL DISC. FILTER
BACKWASH CONTROL PANEL

DWN BY:
BMF

DATE:
07/05/18

SCALE:
N.T.S.

DWG. NO. :
3/3

JOB NO. :
CP-1818

BILL OF MATERIALS

ITEM	QTY.	MANUFACTURER	PART NUMBER	DESCRIPTION
1	1	STAHLIN	RJ1614HPL	ENCLOSURE
2	1	SQUARE D	QOU115	CB1
3	2	PHOENIX	UT4 HESI	FU1,2
4	2	IDEC	PY2SULAC24	CR1,2
5	1	SIEMENS	OBA8	PLC
6	1	WHITE RODGERS	90T40F3	120V/24V TRANSFORMER
7	1	STOCK	E-Z SWITCH	E-Z SWITCH
8	1	MURPHY	A20DP-K-15	DIFF. PRESSURE SWITCH
9	1	EBT	511-1548	24VAC LED LIGHT
10	1	ABB	CL100-R	LED LIGHT HOLDER
11				
12				
Delta Treatment Systems
9125 Comar Drive Walker, LA 70782

BILL OF MATERIALS DUAL DISC. FILTER BACKWASH CONTROL PANEL

DWN BY:
BMF

DATE:
07/05/18

SCALE:
N.T.S.

DWG. NO. :

JOB NO. :
CP-1818

