


PANEL FRONT LAYOUT

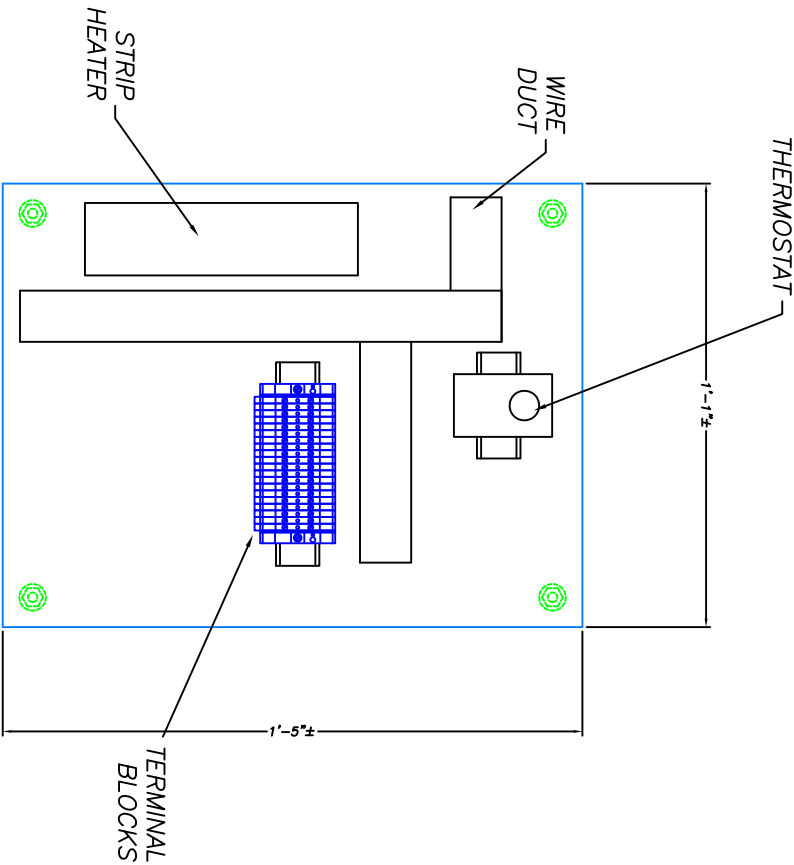

BACK PANEL LAYOUT

CP-1769

REV. NO.	AS BUILT	DESCRIPTION	DATE	DRN	CHK
0	AS BUILT		05/01/01	GU	
<b>G-H Systems</b> SYSTEMS FOR WATER AND WASTEWATER TREATMENT					
10805 METRIC BLVD. - AUSTIN, TEXAS - 78758					
TELEPHONE: (512) 836-3883 - FAX: (512) 836-4441					
REPUBLIC, MO					
WASTEWATER TREATMENT PLANT					
GRIT & GREASE BRIDGE CONTROL PANEL					
PANEL LAYOUT					
THIS DRAWING AND ALL INFORMATION IT CONTAINS ARE THE PROPERTY OF G-H SYSTEMS, INC. AND ARE TO BE USED ONLY WITH THE EXPRESS WRITTEN PERMISSION OF THE EQUIPMENT MANUFACTURER.					
DRAWN BY: RM DATE: 07/21/00 SHT 7 OF 8					
APP'D. BY: GU DATE: 09/15/00					
SCALE: NTS JOB NO. 00-665					
FILE: 00665-07 DWS. NO. 07-01-6					
B					REV.
					0